


Morton

KANSAS

SECTION 27 TOWNSHIP 33 RANGE 41W

WELL NO. #1 Barker

COMPANY P.E.P.L.

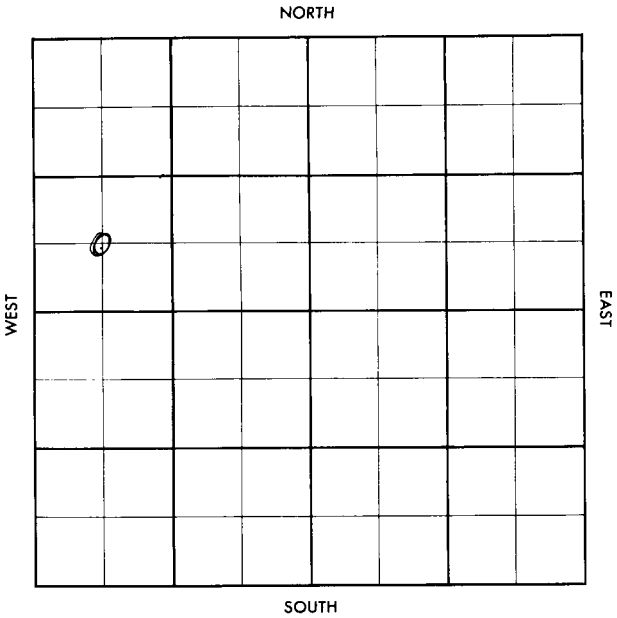

Morton

SEC.	TWP.	R.
27	33	41W

WELL NO.

#1 Barker

FARM

COMPANY

P. E. P. L.

CONTRACTOR

Garvey Tools
Hugoton


_____ FT. FROM N. LINE

_____ FT. FROM S. LINE

_____ FT. FROM E. LINE

_____ FT. FROM W. LINE

C SW NW NE

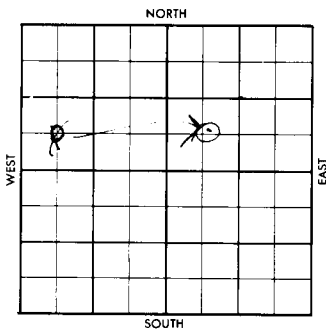

1956

ELEVATION

REPORT

9-12

Comm 9-9-56
7" @ 449 w/200
WOC

County Horton Elev. _____
 Sec. 27 Twp. 33 Rge. 41W
 Company P.E.P.L.
 Farm Name Barker No. 1

TOPS	DEPTH	LOG	DATUM	Loc. in Sec.
Anh.				C SW NW
Tp.				
H.				
Tr.				
Dg.				
Bl.				
L.				Geol. _____
K.C.				Contr. _____
B.K.C.				Garvey Tools
Ce.				Pool _____
C.				Hugoton
M.				
M.				
K.				
Nz.				
Mo.				
V.				
S.				
S.				
A.				
R.				
Pe.				
G.				
TD				

Date Comm. 9-9-567" @ 449 w/200, WOC

SEP 12 1956

SEP 12 1956

CORRECTION

FORM 515 - SUNRAY

County Morton File # 3336
 Sec. 27 Twp. 33 Rge. 41W
 Company P.H.P.L.
 Farm Name Barker No. 1-27

TORS	DEPTH	LOG	DATUM	Loc. in Sec.
Ant.				<u>C SW 1/4 NE</u>
TP <u>KFI</u>		<u>2129</u>		
H. <u>WLD</u>		<u>2189</u>		
Tr.				
Dg.				
Bl.				
L.				
K.C.				Geol.
K.C.				Contr.
Ce.				Garvey Tools
C.				
M.				Plant
M.				Hugoton
M.				
V.				
S.				
M.				
A.				
R.				
P.				
G.				
	<u>2380</u>			

COMPLETE
 DEC 13 '56

State Cont. 929-56
 7" @ 119.3/200, WOC SEP 19 '56 9 1/2 @
2274/1350 SEP 26 '56 CO 40/2191-99
14 tst S.W. 3rd PFS.
CO 2186 20/2130-35 56/
2139-52 32/2156-64 24/
2172-78 1 FRAC 921.622
MCF 14 OCT 3 '56 921.622 MCF
OCT 10 '56 OCT 17 '56 OCT 24 '56 OCT 31 '56 NOV 7 '56 NOV 13 '56
NOV 21 '56 NOV 28 '56 DEC 12 '56 3rd Deliv TST
682 MCF RP 407.1