

Morton


KANSAS

SECTION 31 TOWNSHIP 33S RANGE 41W

WELL NO. #1 Minor Gas Unit

COMPANY Pan-American Petr.

NORTH 100' N of C W/2

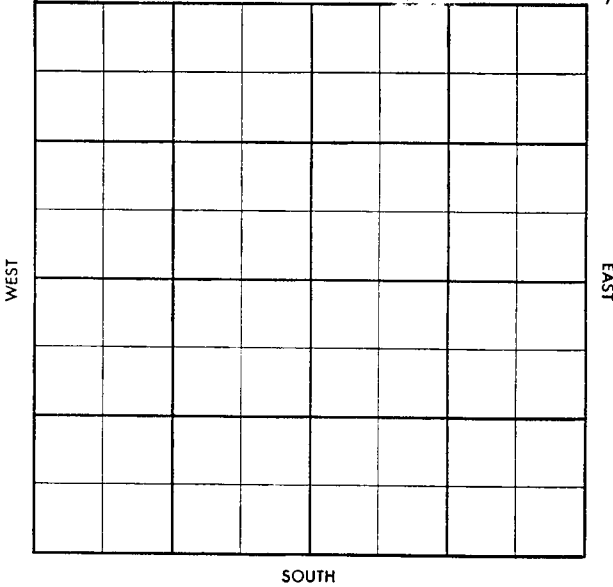

Twp. N Pool N
 Co. X Facet N

5-513-B

County Morton Elev. 2360 DE 336340
 Sec. 31 Twp. 33 Rge. 11W
 Company Pen-American Pet.
 Farm Name Minor Gas Unit No. 1

TOPS	DEPTH	LOG	DATUM
Anh.	<u>1405</u>		
Tp.			
H. <u>WPA</u>		<u>2739</u>	
Tr. <u>TP</u>		<u>2971</u>	
Dq. <u>WPA</u>		<u>3183</u>	
B.L. <u>Mesonorian</u>		<u>3382</u>	
L.		<u>3500</u>	
K.C.			
B.K.C.			
Co.			
C.			
M.			
M.			
K.			
Mz.			
Mq.			
V.			
S.			
S.			
A.			
R.			
Pf.			
G.			
T.D.	<u>3700</u>		

Loc. in Sec. 100' N of

C W/2

Geol.

Contr.

Barbour

Pool

Greenwood

COMPLETE

MAR 19 1958

Date Comm. 2-25-58 8" 1453/800
 R U R MAR 5 58 MAR 12 58 Log 4" 3270/200
 W O C T MAR 10 58 24/3118-22 12/3108
 -10 25/3035-38 18/3014-17
 gr 275 muf net (2) 10 h. B/10 dca
 2.920 muf op Flo 5.100 muf
 SICP 400 SITP 400
 TP 3014-3122

County Morton Elev. _____
 Sec. 31 Twp. 33 Rge. 11W
 Company Pan-American Pet.
 Farm Name Minor Gas Unit No. 1

TOPS	DEPTH	LOG	DATUM
Anh.			
Tr.			
H.			
Tr.			
Dg.			
B. L.			
L.			
K.C.			
B.K.C.			
Co.			
C.			
M.			
M.			
K.			
Mz.			
Mq.			
V.			
S.			
S.			
A.			
R.			
Pf.			
G.			
T.D.			

Loc. in Sec. _____

100' N of
C W/2

Geol. _____

Contr. _____

Barbour

Pool _____

Greenwood

Date Comm. _____

RUR

Co.

Lse.

No.

Sec.

T.

R.