


Section 22 Township 19 Range 20W

Well No. #1 Bennister

Company Carl Todd et al

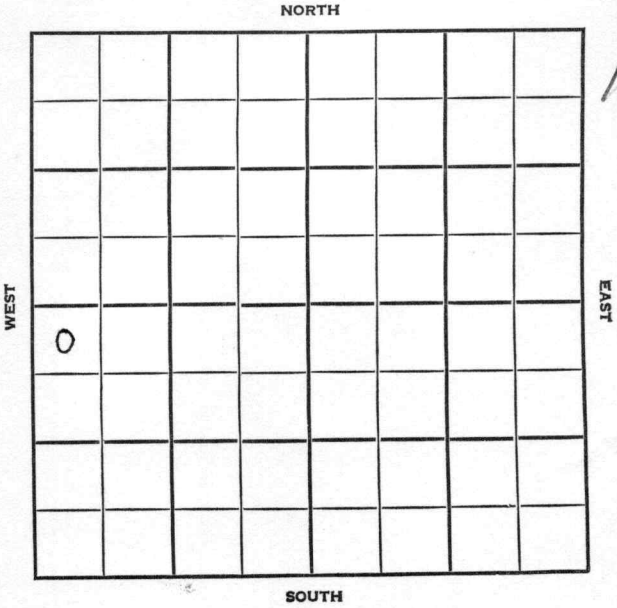

Rush

KANSAS

SEC.

TWP.

R.

22

19

20W

WELL NO.

1 Bennister

FARM

COMPANY

Carl Todd et al

CONTRACTOR

Co. Tools


Wildcat

Ft. from N. Line

Ft. from S. Line

Ft. from E. Line

Ft. from W. Line

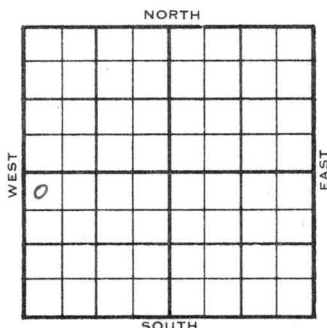

NW NW SW

ATL. DHM - Skelly FO

1955

ELEVATION

2286

REPORT

8/17

Comm 8-14-55

8" @ 201/150

Drlg 2705

8/31

Comm 8-14-55

Tp 3509

H 3785

3787

Tr 3807

3809

Dg 3820

L 3830

3832

BKC 4148

Ce 4285

M 4396

4423

V 4550

4593

S 4732

4733

A 4757

4757

TD 4783

8" @ 201/150

DST 4280-4322 open 1/2 hr

Rec 10' mud 0/15"

DST 4324-37 open 1 hr

Rec 2460' sw 1260/15"

D & A

ABANDONED

County Rush Elev. _____ Co.
 Sec. 22 Twp. 19 Rge. 20W
 Company Carl Todd et al.
 Farm Name Bannister No. 1

TOPS	DEPTH	LOG	DATUM	Loc. in Sec.	Lse.
Anh.				NW NW SW	
Tr.					
Dg.					
B.L.					
L.					
K.C.				Geol.	
B.K.C.				Contr.	
Ce.				Co. tools	
C.					
M.				Pool	
M.				Wildcat	
K.					
Mz.					
Ma.					
V.					
S.					
S.					
A.					
R.					
Pe.					
G.					
T.D.					

Date Comm. 8-14-55 Atl. DHM - Skelly FO
 8" @ 201/150 orlg. 2705

14

County Rush Elev. 2286 Co. 1
 Sec. 22 Twp. 19 Rge. 20W
 Company Carl Todd et al.
 Farm Name Bannister No. 1

TOPS	DEPTH	LOG	DATUM
Anh.			
T.P.	3509		1223
H.	3785	3787	1501
Tr.	3807	3809	1523
Dg.	3820		1534
BL.			
L.	3830	3832	1546
K.C.			
B.K.C.	4148		1865
Ce.	4285		1999
C.			
M.	4396	4423	2137
M.			
K.			
Mz.			
Mq.			
V.	4550	4593	2307
S.	4732	4733	2447
S.			
A	4757	4757	2471
R.			
PE.			
G.			
T.D.	4782		

Loc. in Sec. NW NW SWGeol. Contr. Co. tools Pool Wildcat 

Date Comm. 8-14-55 AUG 31 1955
8" @ 201/150 DST 4280-4322 open 1/2 hr.

Rec. 10' mud 0/15" DS 4324-37

open 1 hr. Rec. 2460' sw 1260/15"

D & A