



KANSAS

Map No. \_\_\_\_\_ Sec. 5 Twp. 32 R. 5

Well No. 1 - Buck Farm \_\_\_\_\_

Lewis Gas Product Company


\_\_\_\_\_ Ft. from N. Line

330 Ft. from S. Line

\_\_\_\_\_ Ft. from E. Line

330 Ft. from W. Line

1928

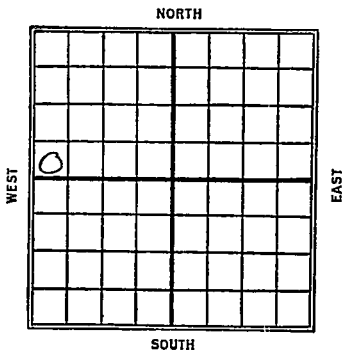

Date

REPORT

Date	REPORT
1/11	Rig up
1/18	Rig
1/26	Rigging up -
2/2	Drill - 450
2/9	Dry sand 1410-48 - drill -
2/16	Drilling - 2050
2/23	Sand 2337-53 - Est 20 bbl -
3/1	7 bbls oil in 20 hrs - <sup>Show</sup>
3/8	Dry sand 1410 - 48 -
	Sand 2337-53 - 7 bbls
	oil in 20 hrs -
3/16	Drilling 2610 -
3/22	" 2800
3/28	7 bbl show 2337-53
	Top line 3082'
	A. & A. 3085'

*Cawley*

Map No. 2 KANSAS Sec. 5 Twp. 32 R. 5

Well No. 1 *Buck*  
*Lewis Gas Product Co.* Company

Contractor

FIRST REPORTS

SECTION PLAT

\_\_\_\_\_ Ft. from N. Line  
330  
 \_\_\_\_\_ Ft. from S. Line  
 \_\_\_\_\_ Ft. from E. Line  
330  
 \_\_\_\_\_ Ft. from W. Line

o			

Location \_\_\_\_\_  
 Rig up   
 Drilling and Remarks:

RECORD

Cased \_\_\_\_\_ in., \_\_\_\_\_ ft.  
 Sand \_\_\_\_\_  
 Gas \_\_\_\_\_  
 Oil \_\_\_\_\_  
 Total Depth \_\_\_\_\_

PRODUCTION

1st 24 hrs. Nat. \_\_\_\_\_  
 1st 24 hrs. after shot \_\_\_\_\_  
 Gas \_\_\_\_\_ Cu. Ft.  
 Dry Hole \_\_\_\_\_  
 Abandoned \_\_\_\_\_

Date  
 JAN 11 1928

102 CHAS. L. SHERWOOD Scout

Cowley

2 KANSAS

Map No. \_\_\_\_\_ Sec. 5 Twp. 32 R. 5

Well No. 1 Buck

Lewis Gas Products Co Company

Contractor

COMPLETED

SECTION PLAT

\_\_\_\_\_ Ft. from N. Line

330

\_\_\_\_\_ Ft. from S. Line

\_\_\_\_\_ Ft. from E. Line

330

\_\_\_\_\_ Ft. from W. Line

ABANDONED

0			

Location \_\_\_\_\_

Rig up \_\_\_\_\_

Drilling and Remarks:

7 Bl show 2337-53'

TL 3082

Ma 3085

RECORD

Cased \_\_\_\_\_ in., \_\_\_\_\_ ft.

Sand \_\_\_\_\_

Gas \_\_\_\_\_

Oil \_\_\_\_\_

Total Depth 3085

PRODUCTION

1st 24 hrs. Nat. \_\_\_\_\_

1st 24 hrs. after shot \_\_\_\_\_

Gas \_\_\_\_\_ Cu. Ft.

Dry Hole

Abandoned

Date

MAR 28 1928

CHAS. L. SHERWOOD

192

Scout