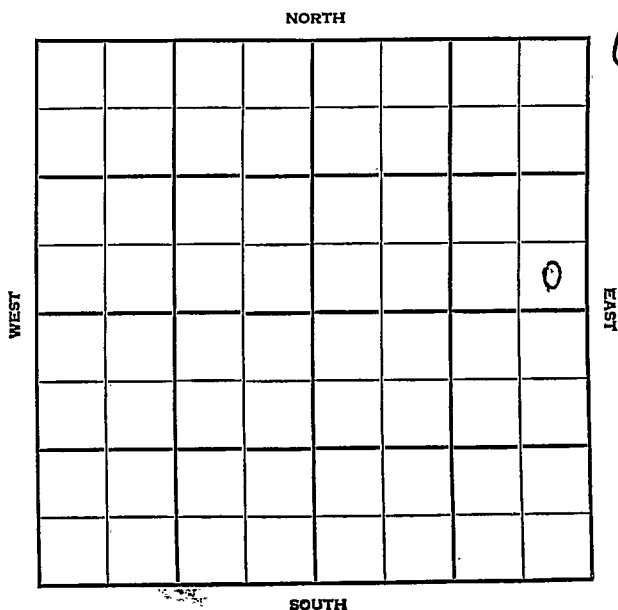


Section 35 Township 19 Range 20 WWell No. # 1 CarrCompany N C R A et al

Rush

KANSAS

SEC.	TWP.	R.
35	19	20 W

WELL NO.

1 Carr

FARM

COMPANY

N C R A et al

CONTRACTOR

Sterling

Wildcat


_____ Ft. from N. Line

330 _____ Ft. from S. Line

330 _____ Ft. from E. Line

_____ Ft. from W. Line

SE SE NE

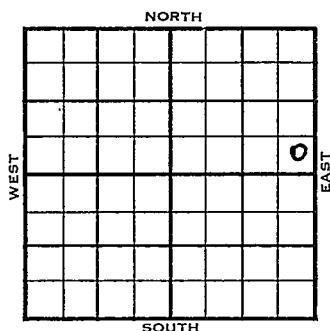

Amerada DHM

	ELEVATION	REPORT
1955	2247'	
2/16	MIR	
3/9	Spud 2-16-55 - D&A	
	TD 4694'	
	8" @ 480'	
	Heeb. 3738', Lans. 3782', Top 3383',	
	Dodge 3758', Cherokee 4241'	
	DST 4219-46', op 1 hr., rec. 10' mud,	
	O#	
	Cong. 4291', Miss 4352'	
	DST 4484-4501', opn 1 hr., rec. 15'	
	mud, 1218#	
	Misener 4502', Viola 4528', Simp 4646',	
	Arb. 4659'	
	TD 4694'	
	Log Tops: Heeb. 3740', Lans 3786',	
	Cherokee 4241', Cong. 4291', Miss.	
	4350', Misener 4504', Viola 4530',	
	Simp. 4636', Arb. 4658'	
	D&A	
		ABANDONED

County **Rush** State **Kansas**

Sec. **35** (Blk.) **19** (Sur.) **20W** Map No.

Operator **N C R A et al.**

Well No. **1** Farm **Carr**

[illegible]

0

FIRST REPORT

330 Ft. From S Line NE

330 Ft. From E Line Quarter

1st. Report FEB 16 1955

Completion _____

Remarks **Amerada - DEIN**

Sterling - Contr.


Spudding Date _____

Drlg. Data **Wildcat**

M I R

FABEN GILSTRAD

County Rush State Kansas
 Sec. 35 (Blk. 19 (Sur. 20W Map No.
 (Twp.) (Rge.)
 Operator N C R A etal.
 Well No. 1 Farm Carr
 Elev. 2247 Location SE SE NE

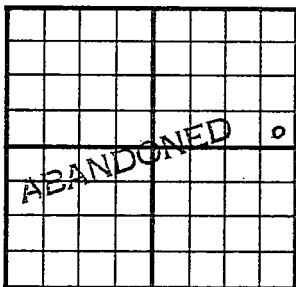

330Ft. From S Line NE
330Ft. From E Line Quarter
 Ist. Report MAR 9 1955
 Completion
 Remarks Wildcat
Sterling - Contr.
 Spudding Date 2-16-55

Drig. Data D & A TD 4694

8" @ 480 Heeb. 3738 Lans. 3782

Top. 3383 Dodge 3758 Cherokee 4241

DST 4219-46 open 1 hr. Rec. 10' mud

0# Cong. 4291 Miss. 4352 DST 4484-

4501 open 1 hr. Rec. 15' mud 1218#

Misener 4502 Viola 4528 Simp. 4646

Arb. 4659 TD 4694 LOG TOPS:

Heeb. 3740 Lans. 3786 Cherokee 4241

Cong. 4291 Miss. 4350 Misener 4504

Viola 4530 Simp. 4636 Arb. 4658

D & A

FABEN GILSTRAP