


Section 27 Township 19 Range 15 W

Well No. # 1 Zimmer

Company Schermerhorn Oil

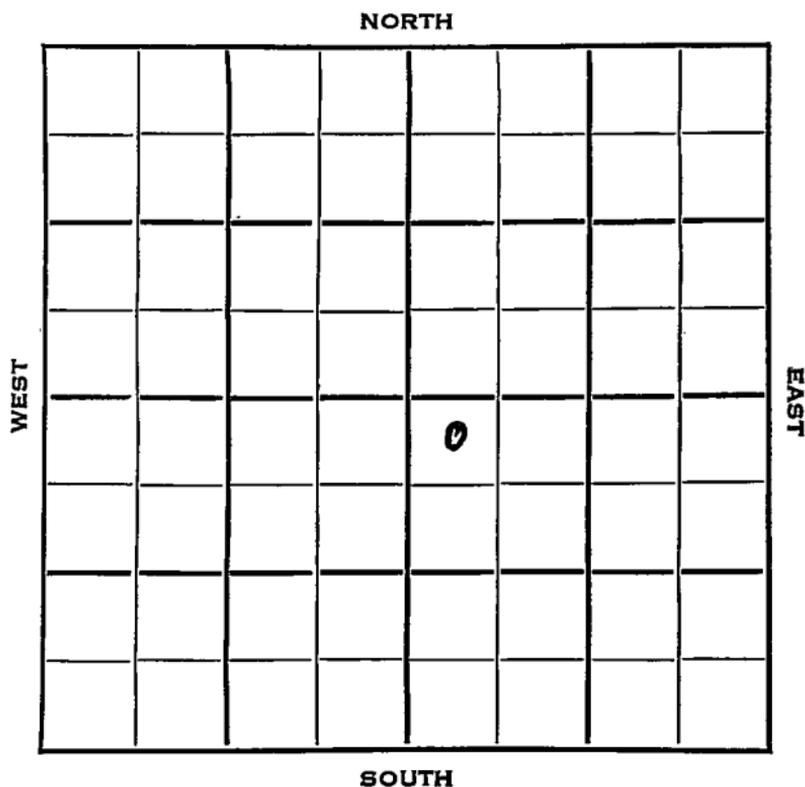

Barton

KANSAS

SEC.	TWP.	R.
27	19	15W ✓

WELL NO. _____
 COMPANY **1 Zimmer** FARM

CONTRACTOR **Schermerhorn Oil**
Badger


Pendergast Pool
 330 _____ Ft. from N. Line

_____ Ft. from S. Line

_____ Ft. from E. Line

330 _____ Ft. from W. Line

NW NW SE

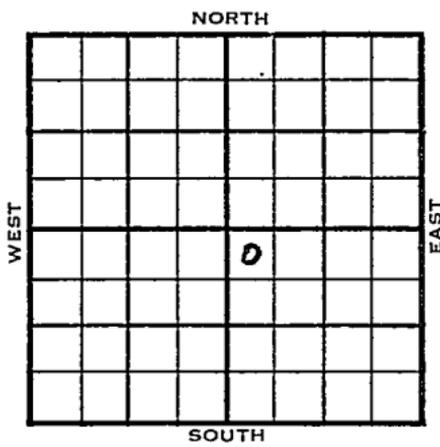

1953	ELEVATION 1924'	REPORT
------	--------------------	--------

9/30 Location

10/14 8" @ 885 w/450
Drlg. 2920'

10/21 D & A

10/28 Spud 10-5-53 D & A TD 3611
 8" @ 885 Heeb 3184 Tor. 3201
 Doug. 3214' Br lime 3268'
 Lans 3283 B KC 3501 Cong 3541
 Arb. 3590'
 DST 3605-11 open 1 hr rec 35' mud
 380# TD 3611'
 D & A

ABANDONED

