

Section 26 Township 19 Range 20 WWell No. # 1 AndersonCompany Aurora Gas & Strain Drlg.

NORTH

							0

SOUTH

WEST

EAST

8

Rush

KANSAS

SEC.	TWP.	R.
26	19	20 W ✓

WELL NO.

1 Anderson

FARM

COMPANY

Aurora Gas & Strain Drlg.

CONTRACTOR

Wildcat

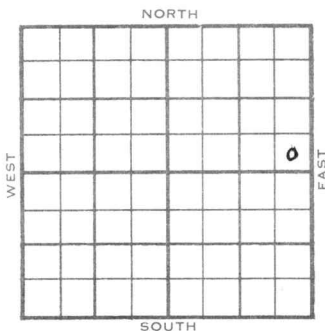
Ft. from N. Line

330 Ft. from S. Line

330 Ft. from E. Line

Ft. from W. Line

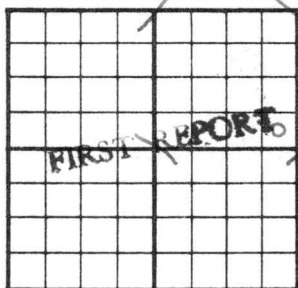
SE SE NE



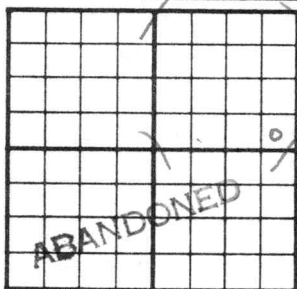
CSO - DHM Skelly - DHM

	ELEVATION	REPORT
1954	2191'	
5/12	Spud 5-8-54 8" @ 189' Anhy 1390' Drlg. 2190'	
5/19	Heeb 3716', Tor 3736', Lans 3764' B KC 4061' Drlg 4095'	
5/26	Spud 5-8-54 D&A TD 4542' 8" @ 189' Anhy 1390', Heeb 3716', Tor 3736', Lans 3764', B KC 4061', Cherokee 4170' & Cong. 4266', Miss 4299', Viola 4417', Simp. 4494', Arb. 4498' DST 4502-42', opn 1 hr., rec. 3250' SW, TD 4542' D&A	

ABANDONED

County Rush State KansasSec. 26 (Blk. Twp.) 19 (Sur. Rge.) 20W Map No.Operator Aurora Gas & Strain Drlg.Well No. 1 Farm AndersonElev. Location SE SE NE330 Ft. From S Line NE330 Ft. From E Line Quarter1st. Report MAY 12 1954Completion CSO - BHMRemarks Skelly - DHMSpudding Date 5-8-54Drlg. Data Wildcat8" @ 189 Anhy 1390 drlg. 2190

J. G. McGEHEE

County Rush State KansasSec. 26 (Blk.
Twp.) 19 (Sur.
Rge.) 20W Map No.Operator Aurora Gas & Strain Drlg.Well No. 1 Farm AndersonElev. 2191 Location SE SE NE330 Ft. From S Line NE330 Ft. From E Line Quarter1st. Report MAY 26 1954

Completion

Remarks WildcatSpudding Date 5-8-54Drlg. Data D & A TD 45428" @ 189 Anhy 1390 Heeb. 3716Tor. 3736 Lans. 3764 B KC 4061Cherokee 4170 Cong. 4266 Miss. 4299Viola 4417 Simp. 4494 Arb. 4498DST 4502-42 open 1 hr. Rec. 3250' swTD 4542D & A

J. G. McGEHEE