


Section 28 Township 19 Range 15 W
Well No. #1 N. G. Gagelman
Company Texas Co.

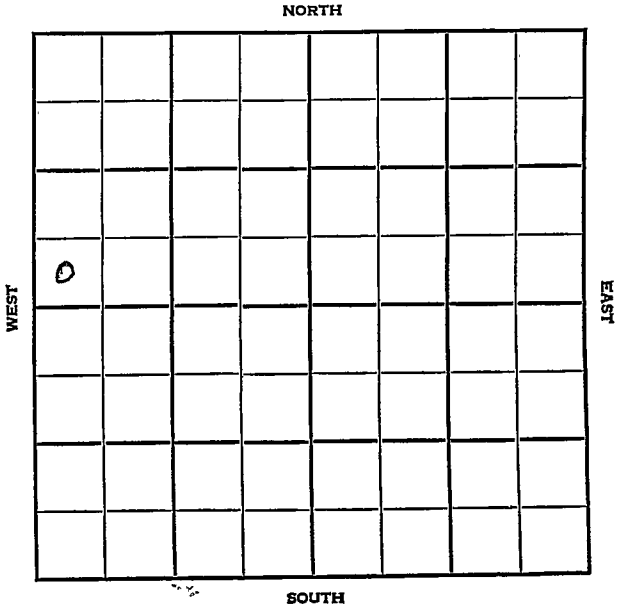

Barton

KANSAS

SEC. 28	TWP. 19	R. 15W
------------	------------	-----------

WELL NO.

#1 N.G. Gagelman

FARM

COMPANY

Texas Company

CONTRACTOR

Prime

#1 NE Behrens


Ft. from N. Line

Ft. from S. Line

Ft. from E. Line

Ft. from W. Line

SW SW NW

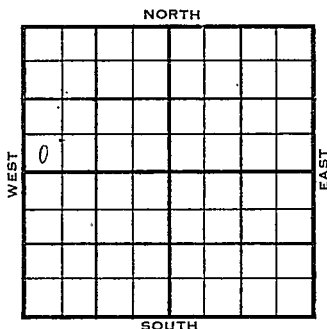

1956	ELEVATION 1946'	REPORT
2-8	Comm. 2-4-56 10" @ 937/525 WOC	
4-25	DST 3430-45 op 1 hr. rec. 25' drlg.mud 40/15" DST 3642-48 op 1 hr. gas in 12 min. rec. 239' oil, 1080/30" 7" @ 3644/125 CO to 3648 S/ 1 $\frac{1}{4}$ bo, 1 hr., 1,293 mcf g DD 3650, 250 A F/ 11 bo 24 hrs. F/ 12 $\frac{1}{2}$ bf, 8 hrs. F/ 25 bf, 21 hrs., 70% wtr., 500 A F/ 7 $\frac{1}{2}$ bo, 17 bw, Comp. 2600 mcf gpd Log tops: H. 3210 BL. 3290 L. 3300 BKC 3523 C. 3564 A. 3606 TD 3648'	

COMPLETED

County Barton Elev. 157
Sec. 28 Twp. 15N Rge. 15W
Company Texas Company
Farm Name N. G. Gagelman No. 1

TOPS	DEPTH	LOG	DATUM
Anh.			
Tr.			
H.			
Dg.			
Bl.			
L.			
K.C.			
B.K.C.			
Ce.			
C.			
M.			
M.			
K.			
Mz.			
Ma.			
V.			
S.			
S.			
A.			
R.			
Pe.			
G.			
T.D.			

Loc. in Sec. SW SW NW
Geol. Prime
Contr. NE Behrens
Pool NE Behrens
FIRST REPORT
FEB 8 '55

Date Comm. 2-1-56
10" @ 937/525 WOC.

2

County Barton Elev. 1946
 Sec. 28 Twp. 19 Rge. 15W
 Company Texas Company
 Farm Name N. G. Gagelman No. 1

TOPS	DEPTH	LOG	DATUM	Loc. in Sec.
Anh.				SW SW NW
Tr.				
H.		3210		
Tr.				
Dg.				
Bl.		3290	1344	
L.		3300	1354	Geol.
K.C.				Contr.
B.K.C.		3523	1577	Prime
Ce.		3564	1618	Pool
C.				NE Behrens
M.				
M.				
K.				
Mz.				
Me.				
V.				
S.				
S.				
A.		3606	1660	
R.				
PE.				
G.				COMPLETE
T.D.	3648			

Date Comm. 2-4-56 APR 25 1956
 10" @ 937/525 DST 3430-45 open 1 hr.
 rec. 25' drlg. mud. 40/15"
 DST 3642-48 open 1 hr. gas in 12 min.
 rec. 239' oil 1080/30" 7" @ 3644/125
 C⁰ to 3648 S/ 1 1/4 bo 1 hr. 1;293 mcfg
 DD 3650 250 A F/ 11 bo 24 hr.
 F/ 12 1/2 bf 8 hr. F/ 25 bf 21 hr.
 70% wtr. 500 A F/ 7 1/2 bo 17 bw
 Comp. 2,600 mcfgpd