


Section 31 Township 19 Range 15-W

Well No. #2, Tammen

Company Cities Service Oil Company

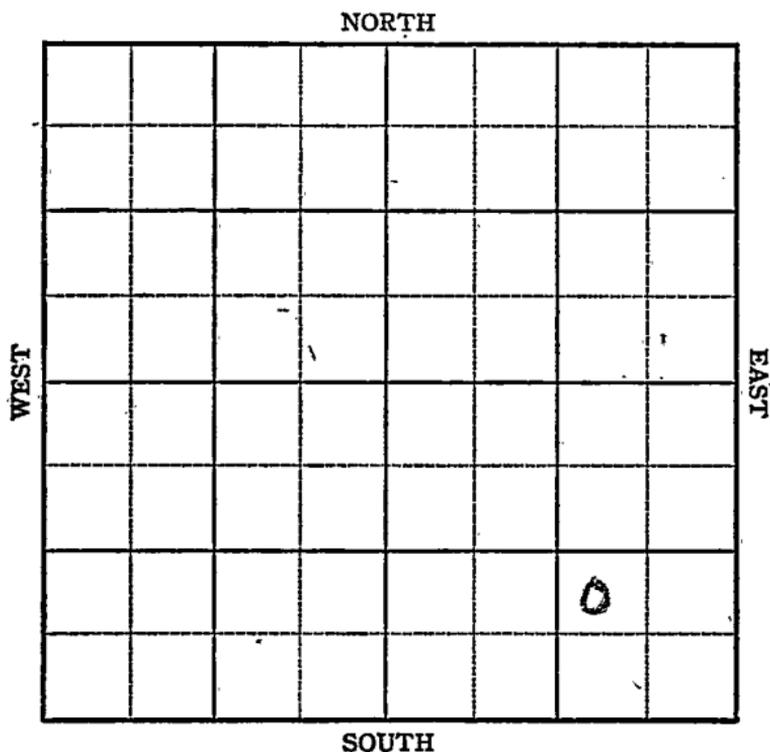

Sec. 31 Twp. 19 R. 15-W

Well No. #2 Tammen Farm

Cities Service Company

Behrens Pool

 Ft. from N. Line


990 Ft. from S. Line

990 Ft. from E. Line

 Ft. from W. Line

Close our acreage

NW SE SE

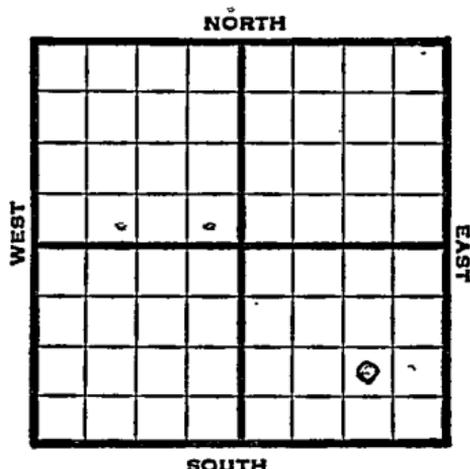

1947 1977 REPORT

- 2/5 Location
- 2/12 RUR
- 2/19 8" @ 1003'
Drlg 1695'
- 2/26 Drlg 3320'
- 3/4 Lans 3354
Arb 3638
TD 3745
5" @ 3745'
RUST
- 3/11 24 shots 3703-08
500 Acid
Flow 15 bbls oil & 9 W in 24 hrs
- 3/18 TD 3745'
- 3/25 24 shots 3704-08 - 1000 Acid
Swab 47 bbls oil & 10 water in 24 hrs
- 4/2 " " "
- 4/9 " " "

OVER

4/16

Arb. 3638

5" @ 3745

Perf

1500 Acid

Pump 86 oil & 16% W Pot

Grav. 39.7

TD 3745'

COMPLETED

Kansas KANSAS

Map No. K82 Sec. 31 Twp. 19 R. 15W

Well No. 2 Tammen

Cities Service Company


COMPLETE

Contractor

E. H. 1977

SECTION FLAT

NW SE SE

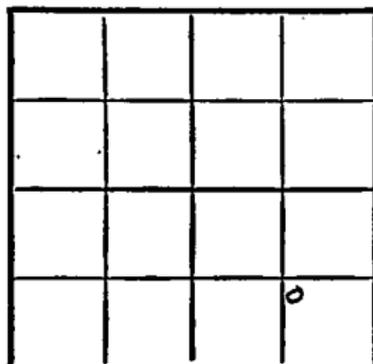

_____ Ft. from N. Line

990 Ft. from S. Line

990 Ft. from E. Line

_____ Ft. from W. Line

Barton County

RECORD

Location _____

Cased _____ in, _____ ft.

Rig up _____

Sand _____

Drilling and Remarks:

Gas _____

Oil _____

Total Depth 3745

PRODUCTION

1st 24 hrs. Nat. _____

1st 24 hrs. after shot _____

Gas _____ Cu. Ft.

Dry Hole _____

Abandoned _____

Ar 82638
5" @ 3745
Prof.
1500 acid
Pump 86 oil + 16 7/8
B.D.
897 Gr.

Date

APR 16 1947 19

S. J. LEWIS Scout