


Section 31 Township 19 Range 15 W

Well No. 3 Werhahn "A"

Company Inland Oil

Behrens

NORTH

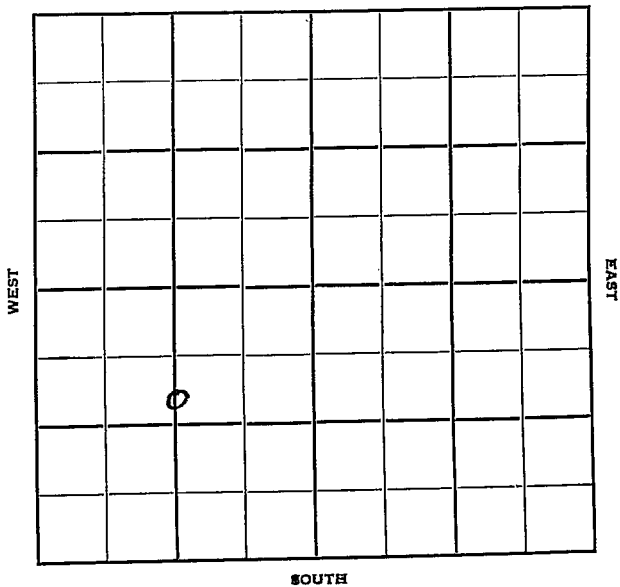


Sec. 3 Twp. 19 R. 15Well No. #3 Werhahn "A" Farm

Inland Oil

Company

(Mallard Drlg. Cont.)

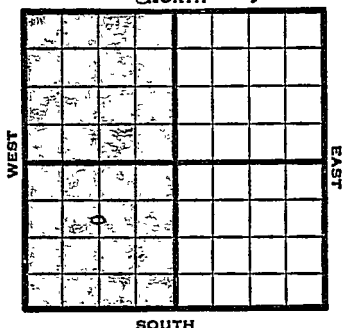990' Ft. from N. Line Ft. from S. Line1320' Ft. from E. Line Ft. from W. LineC S L N $\frac{1}{2}$ SW

1949

Elev 1970' REPORT

9/21

RUR

9/28

8" @ 982'

Drlg 1930'

10/5

Lansing 3367'

Drlg 3616'

10/12

Arb. 3625'

5" @ 3770 TD

10/19

37 shots 3702-07

1000 acid

Flow 60 bbls oil 24 hrs.

10/26

"

11/2

TD 3770'

Lansing 3367'

Arb. 3625'

5" @ 3770'

Perf 1000 acid

Flow 60 oil Pot

39° Gr.

Comp

COMPLETED

Map No. _____ Sec. 31 Twp. 19 R. 15W

Well No. 3 Werhahn "A"

Inland Oil _____ Company

Mallard Drlg. _____ Contractor

C S L N $\frac{1}{2}$ SW


FIRST REPORT
SECTION PLAT

990 Ft. from N. Line

_____ Ft. from S. Line

1320 Ft. from E. Line

_____ Ft. from W. Line

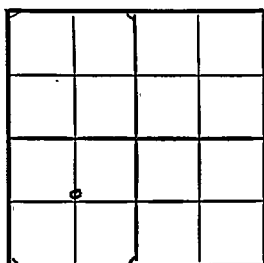

Barton County

RECORD

Location _____

Cased _____ in., _____ ft.

Rig up _____

Sand _____

Drilling and Remarks:

Gas _____

Oil _____

Total Depth _____

R U R

PRODUCTION

1st 24 hrs. Nat. _____

1st 24 hrs. after shot _____

Gas _____ Cu. Ft.

Dry Hole _____

Abandoned _____

Date

SEP 21 1949

19

S. J. LEWIS

Scout

Kansas

Behrens Pool

Map No. _____ Sec. 31 Twp. 19 R. 15WWell No. 3 Werhahn "A"

Inland Oil

Company

COMPLETE

Contractor


C S L N $\frac{1}{2}$ SWEl. 1970
SECTION PLAT990

Ft. from N. Line

Ft. from S. Line

1320 Ft. from E. Line

Ft. from W. Line

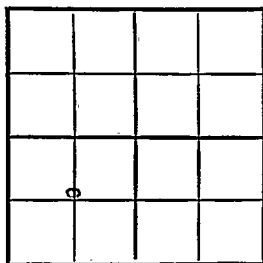

Barton County

Location _____

Rig up _____

Drilling and Remarks:

Lease 3367Ac 836255-83770Perf.1000 acFlow 60 oil1292 lb

RECORD

Cased _____ in., _____ ft.

Sand _____

Gas _____

Oil _____

Total Depth 2770

PRODUCTION

1st 24 hrs. Nat. _____

1st 24 hrs. after shot _____

Gas _____ Cu. Ft.

Dry Hole _____

Abandoned _____

Date

NOV 2 1949

19

S. J. LEWIS

Scout