

Section 32 Township 32 Range 4E

Well No. #1 Country Club

Company K. T. Weidemann

Miscellaneous

NORTH

A blank grid map for plotting a course. The grid is 8 squares wide and 8 squares high. The left edge is labeled "WEST" and the right edge is labeled "EAST". A small number "0" is written in the second square from the bottom-left corner.

SOUTH

Cowley

KANSAS

Sec. 32 Twp. 32 R. 4E

Well No. #1 Country Glux Farm

K. T. Weidemann

Company

Miscellaneous (Weidemann, Contr.)

NORTH

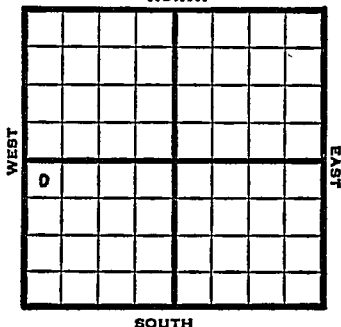
330' Ft. from N. Line

 Ft. from S. Line

 Ft. from E. Line

330' Ft. from W. Line

NW SW



1949 Elev 1200' REPORT

12/7 Location
12/14 "
12/21 "
12/28 8"@ 125'
1950
3/22 8"@ 125
Bart 3156-62
5½"@ 3162'
Miss 3205'
TD 3262'
PB 3202'
Swab 25 BOPD
80 qts 3196-3202'
Temp Aband.
Aband.

ABANDONED

Kansas

Map No. _____ Sec. 32 Twp. 32 R. 4EWell No. 1 CountryClux

_____ K. T. Weidemann _____ Company

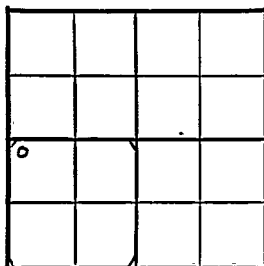
_____ Weidemann _____ Contractor

NW SW

FIRST REPORT
SECTION PLAT330 Ft. from N. Line

_____ Ft. from S. Line

_____ Ft. from E. Line

330 Ft. from W. Line

Cowley County

Location X

Rig up _____

Drilling and Remarks:

RECORD

Cased _____ in., _____ ft.

Sand _____

Gas _____

Oil _____

Total Depth _____

PRODUCTION

1st 24 hrs. Nat. _____

1st 24 hrs. after shot _____

Gas _____ Cu. Ft.

Dry Hole _____

Abandoned _____

Date

DEC 7 1949 19 S. J. LEWIS Scout

Map No. _____ Sec. 32 Twp. 32 R. 4EWell No. 1 Country ClubK. T. Weidemann Company

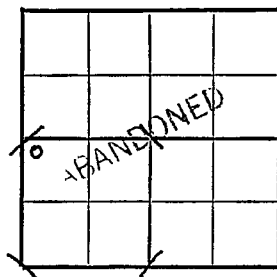
Contractor

NW SW

E. 1200
SECTION PLAT330 Ft. from N. Line

_____ Ft. from S. Line

_____ Ft. from E. Line

330 Ft. from W. LineCowley County

Location _____

Rig up _____

Drilling and Remarks:

8" @ 125
 Bart. 3156-62
 5 1/2" C 3162
 Miss. 3205
 T.D. 3262
 PB 3202
 Swab 25 hops
 80 ft 3196-3202

Date

Temp. abt

RECORD

Cased _____ in., _____ ft.

Sand _____

Gas _____

Oil _____

Total Depth _____

PRODUCTION

1st 24 hrs. Nat. _____

1st 24 hrs. after shot _____

Gas _____ Cu. Ft.

Dry Hole _____

Abandoned _____

MAR 22 1950 19

J. E. TYRA

Scout