

KANSAS


FORM 51 5M 11-44 PETROL

Barton County

Section 32 Township 19 Range 15W

Well No. #1 Maulstof

Company Champlin Ref.

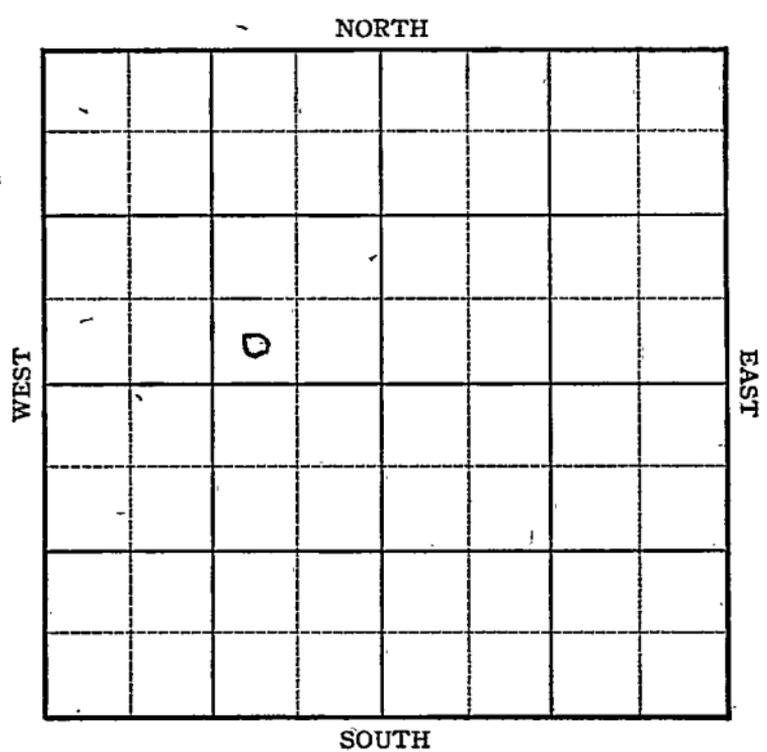

Sec. 32 Twp. 19 R. 15W

Well No. #1 Maulstof Farm

Champlin Ref. Company

Wildcat


Ft. from N. Line

330 Ft. from S. Line

990 Ft. from E. Line

Ft. from W. Line

SW SE NW

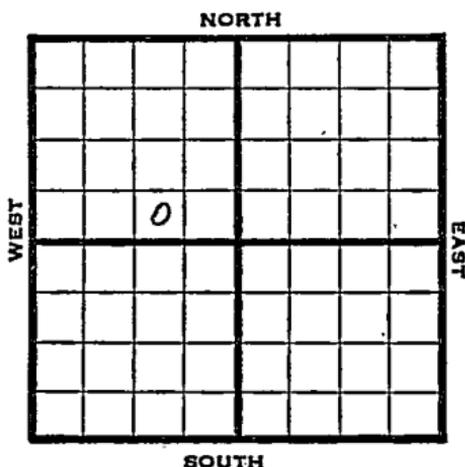

1946

Elev. 1961

REPORT

5/15 Anhy. 995
8" @ 970' WOC

5/29 3640' fsg.

6/5 Lans 3348
Cong 3600
Arb. 3664
TD 3770'

ABANDONED


KANSAS Kansas Pool Name WildcatMap No. 82 Sec. 32 Twp. 19 R. 15WWell No. 1 Maulstof

Champlin Ref. _____ Company _____

FIRST REPORT _____ Contractor _____

SW SE NW

SECTION PLAT

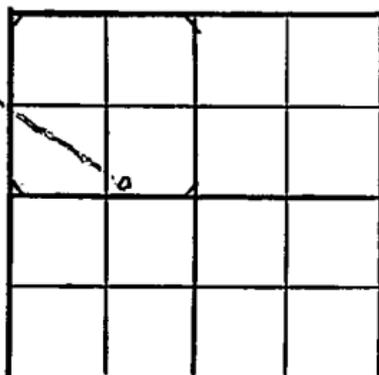

_____ Ft. from N. Line

330 Ft. from S. Line990 Ft. from E. Line

_____ Ft. from W. Line

Barton County

Location _____

Rig up _____

Drilling and Remarks:

*Only 995
8 @ 990 WDC**See
abd Wildcat*

RECORD

Cased _____ in., _____ ft.

Sand _____

Gas _____

Oil _____

Total Depth _____

PRODUCTION

1st 24 hrs. Nat. _____

1st 24 hrs. after shot _____

Gas _____ Cu. Ft.

Dry Hole _____

Abandoned 3770

Date

MAY 15 1946 19S. J. LEWIS Scout

KANSAS

Kansas Pool Name WildcatMap No. 82 Sec. 32 Twp. 19 R. 15WWell No. 1 Maulstof

Champlin Ref.

Company

ABANDONED

Contractor

SW SE NW

E. 1961

SECTION PLAT

_____ Ft. from N. Line

330 Ft. from S. Line990 Ft. from E. Line

_____ Ft. from W. Line

Barton County

Location _____

Rig up _____

Drilling and Remarks:

Lane 3348Cong 3600Per 3664

RECORD

Cased _____ in., _____ ft.

Sand _____

Gas _____

Oil _____

Total Depth 3270

PRODUCTION

1st 24 hrs. Nat. _____

1st 24 hrs. after shot _____

Gas _____ Cu. Ft.

Dry Hole _____

Abandoned _____

Date

JUN 5 1946

19

S. J. LEWIS

Scout