

# KANSAS


Barton

FORM 51 5M PETROL

Section 32 Township 19 Range 15-W

Well No. "1" pillar

Company Helmerick & Payne & Phillips

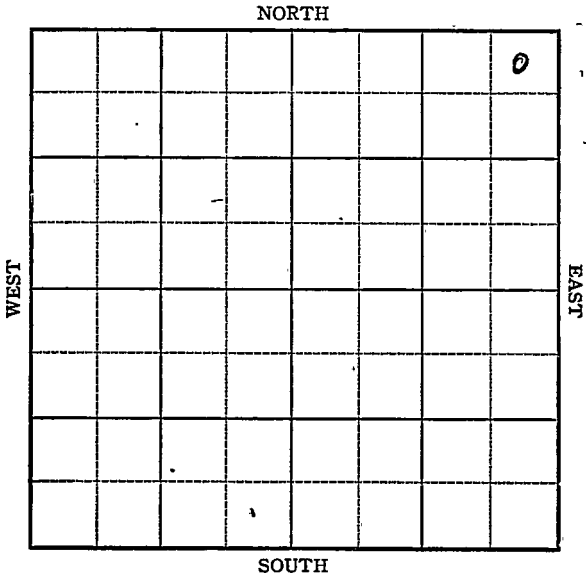

Sec. 32 Twp. 19 R. 15-W

Well No. #1 Piller Farm


Helmerich & Payne & Phillips Company

330 Ft. from N. Line

         Ft. from S. Line

330 Ft. from E. Line

         Ft. from W. Line

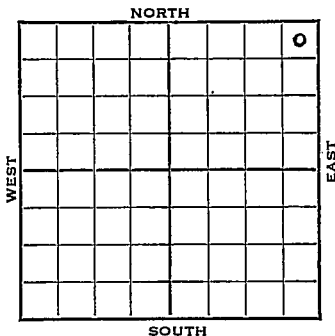

*ELEV. 1951'*

1943

REPORT

8/25	Location
9/1	"
9/8	"
9/15	"
9/22	8" @ 738' 2425' fsg.
9/29	Skid rig 30' west
10/6	Drlg. 755'
10/13	2525 fsg.
10/20	Drlg. 2890'
10/27	Lans 3325 Cong 3580 Drlg. 3621 in cong.
11/3	Arb 3633 5" @ 3635 T.D. 3637 Rust
11/10	Arb 3633 5" @ 3635' T.D. 3690' Water.

KANSAS

Map No. 82 Sec. 32 Twp. 19 R. 15WWell No. 1 PillerHelmerich & Payne & Phillips  
Company

FIRST REPORT

Contractor

NE/C

SECTION PLAT

330 Ft. from N. Line

\_\_\_\_\_ Ft. from S. Line

330 Ft. from E. Line

\_\_\_\_\_ Ft. from W. Line

Wildcat

			0
			5

Location X 7

Rig up \_\_\_\_\_

Drilling and Remarks:

## RECORD

Cased \_\_\_\_\_ in., \_\_\_\_\_ ft.

Sand \_\_\_\_\_

Gas \_\_\_\_\_

Oil \_\_\_\_\_

Total Depth \_\_\_\_\_

## PRODUCTION

1st 24 hrs. Nat. \_\_\_\_\_

1st 24 hrs. after shot \_\_\_\_\_

Gas \_\_\_\_\_ Cu. Ft.

Dry Hole \_\_\_\_\_

Abandoned \_\_\_\_\_

Date

AUG 25 1943<sup>\*</sup> 19

S. J. LEWIS Scout

KANSAS

Map No. 82 Sec. 32 Twp. 19 R. 15WWell No. 1 PillerHelmerich & Payne &Phillips  
CompanyABANDONED

Contractor

NE/C

## SECTION PLAT

330 Ft. from N. Line

\_\_\_\_\_ Ft. from S. Line

330 Ft. from E. Line

\_\_\_\_\_ Ft. from W. Line

			0

Wildcat

Location \_\_\_\_\_

Rig up \_\_\_\_\_

Drilling and Remarks:

Oil 26335" @ 2635Water

## RECORD

Cased \_\_\_\_\_ in., \_\_\_\_\_ ft.

Sand \_\_\_\_\_

Gas \_\_\_\_\_

Oil \_\_\_\_\_

Total Depth 2690

## PRODUCTION

1st 24 hrs. Nat. \_\_\_\_\_

1st 24 hrs. after shot \_\_\_\_\_

Gas \_\_\_\_\_ Cu. Ft.

Dry Hole \_\_\_\_\_

Abandoned \_\_\_\_\_

Date

NOV 10 1943 19S. J. LEWIS Scout