

Section 32 Township 32 Range 4E

Well No. 1 Stayton

Company K T Weidemann

Wildcat
NORTH

WEST

EAST

SOUTH


KANSAS

Cowley

Sec. 32 Twp. 32 R. 4E ✓

Well No. #1 Stayton Farm

K. F. Weidemann Company

Wildcat (Weidemann, Cont.)


NORTH

 Ft. from N. Line

330' Ft. from S. Line

 Ft. from E. Line

330' Ft. from W. Line

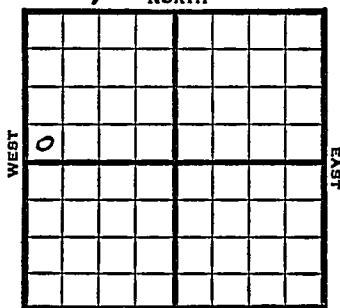

SW NW

SOUTH

1949 Elev 1173' REPORT

5/11 8" @ 120'
Drlg. 1140'
5/18 Drlg 3001'
5/25 Bart 3116'
TD 3129'
5" @ 3122'
6/1 "
6/7 "
6/15 "
6/21 "
6/28 "
7/6 "
7/12 "
7/20 "
7/27 "
8/3 TD 3138 40 qts.
8/10 "
8/17 TD 3141'
Bart 3116'
5"@ 3122'
40 qts
Pump 30 Oil Pot
41° Gr.
Comp

COMPLETED

Map No. _____ Sec. 32 Twp. 32 R. 4E

Well No. 1 Stayton

K. T. Weidemann Company

Weidemann Contractor

SW NW


FIRST REPORT
SECTION PLAT

_____ Ft. from N. Line

330 Ft. from S. Line

_____ Ft. from E. Line

330 Ft. from W. Line

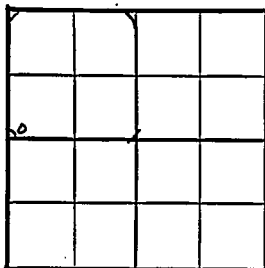

Cowley County

Location _____

Rig up _____

Drilling and Remarks:

8" @ 120

drlg. 1140

RECORD

Cased _____ in., _____ ft.

Sand _____

Gas _____

Oil _____

Total Depth _____

PRODUCTION

1st 24 hrs. Nat. _____

1st 24 hrs. after shot _____

Gas _____ Cu. Ft.

Dry Hole _____

Abandoned _____

Date

MAY 11 1949 19 S. J. LEWIS Scout

Map No. K2 Sec. 32 Twp. 32 R. 4E

Well No. 1 Stayton

K. T. Weidemann Company

COMPLETE

Contractor

SW NW

E 11173

SECTION PLAT

 Ft. from N. Line

330 Ft. from S. Line

 Ft. from E. Line

330 Ft. from W. Line

o			

Cowley County

Location

Rig up

Drilling and Remarks:

Bar X 3116

5" @ 3122

40 ft

Pump 30 oil Bar

412 ft

RECORD

Cased in., ft.

Sand

Gas

Oil

Total Depth 3141

PRODUCTION

1st 24 hrs. Nat.

1st 24 hrs. after shot

Gas Cu. Ft.

Dry Hole

Abandoned

Date

AUG 17 1949 19

S. J. LEWIS Scout