

KANSAS


FORM 51 5M 6-46 PETROL

Barton County

Section 32 Township 19 Range 15W

Well No. #1 Cook

Company C. U. Bay

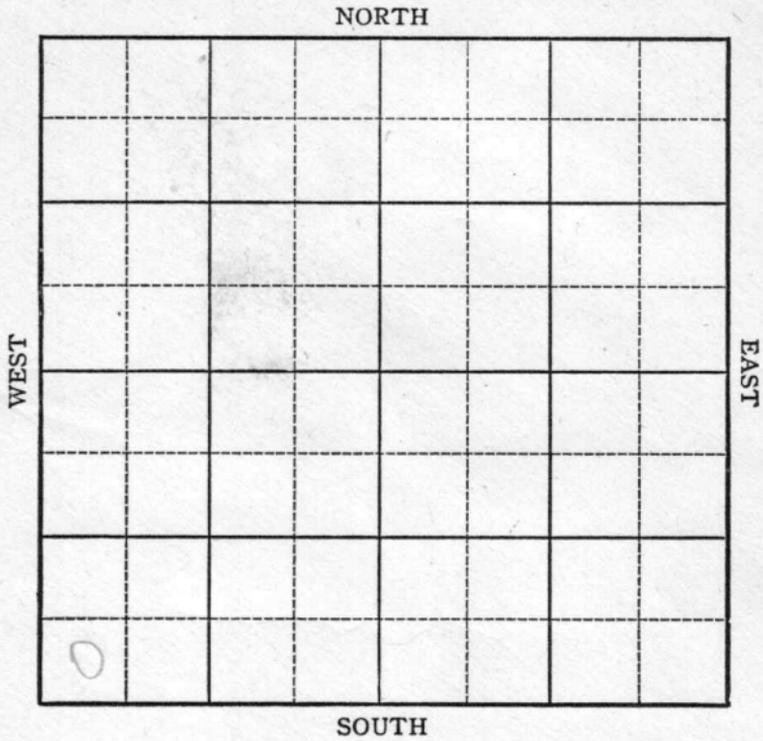


Sec. 32 Twp. 19 R. 15W

Well No. #1 Cook Farm \_\_\_\_\_  
C. U. Bay Company \_\_\_\_\_

Mertens

\_\_\_\_\_ Ft. from N. Line  
330 Ft. from S. Line  
\_\_\_\_\_ Ft. from E. Line  
330 Ft. from W. Line  
SW/c

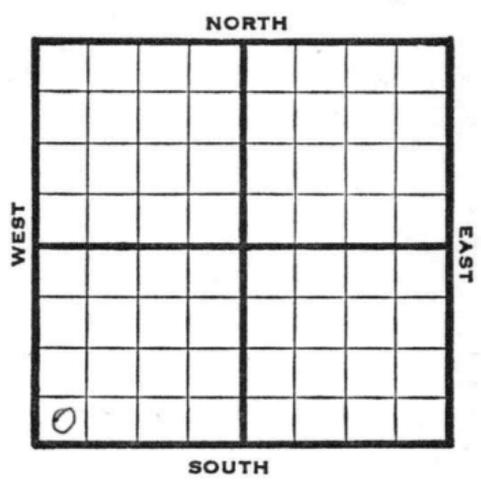

1946 1973 REPORT

7/24 Location  
7/30 Drlg 175'  
8/6 10" @ 970'  
Drlg 3260'  
8/13 Lans 3365  
Arb 3632  
TD 3759  
5" @ 3758 RUST  
8/20 TD 3759 RUST  
8/27 TD 3759'  
35 shots 8702-05, 1500 acid  
swb 4½ oil PH  
9/5 2000 acid flow 5 oil PH  
9/10 " " "  
9/18 " " "  
9/24 " " "  
10/1 " " "  
10/9 Arb 3632'  
5" @ 3758'  
Perf Arb  
3500 Acid  
TD 3759'  
Pump 78 Oil Plus 27 W  
POT  
Grav. 36

COMPLETED

KANSAS

Kansas Pool Name Mertens

Map No. 82 Sec. 32 Twp. 19 R. 15W

Well No. 1 Cook

C. U. Bay Company

**FIRST REPORT**

Contractor

SW/C


**SECTION PLAT**

\_\_\_\_\_ Ft. from N. Line

330 Ft. from S. Line

\_\_\_\_\_ Ft. from E. Line

330 Ft. from W. Line

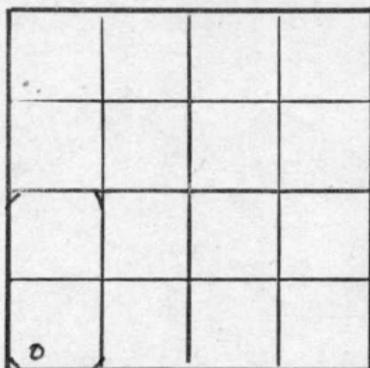

Barton County

Location X

Rig up \_\_\_\_\_

Drilling and Remarks:

**RECORD**

Cased \_\_\_\_\_ in., \_\_\_\_\_ ft.

Sand \_\_\_\_\_

Gas \_\_\_\_\_

Oil \_\_\_\_\_

Total Depth \_\_\_\_\_

**PRODUCTION**

1st 24 hrs. Nat. \_\_\_\_\_

1st 24 hrs. after shot \_\_\_\_\_

Gas \_\_\_\_\_ Cu. Ft.

Dry Hole \_\_\_\_\_

Abandoned \_\_\_\_\_

Date

JUL 24 1946 19

S. J. LEWIS Scout

