

DX 78-1


Cowley KANSAS

Section 35 Township 32 Range 4E

Well No. 2 Harris

Company C. A. Black et al

NORTH

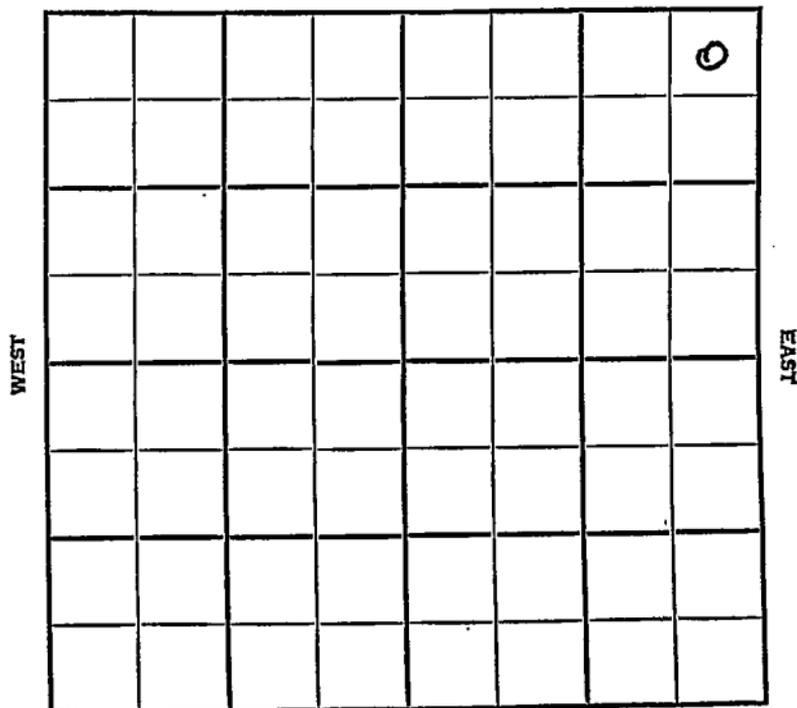

SOUTH

Cowley

KANSAS

SEC.	TWP.	R.
35	32	4 E ✓

WELL NO. # 2 Harris FARM

COMPANY C. A. Black et al

CONTRACTOR Wakefield

Winfield Pool


330 Ft. from N. Line

Ft. from S. Line

330 Ft. from E. Line

Ft. from W. Line

NE NE NE

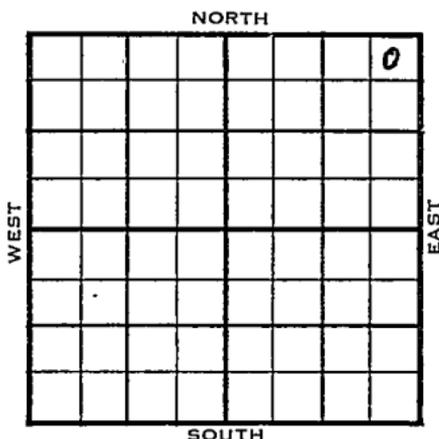

	ELEVATION	REPORT
1954	1217'	

4/27  
6/15

Set surface  
 Oil well TD 3086 8" @ 120  
 Peacock 1476 Layton 2366  
 L. Layton 2372 Stal. 1965  
 KC 2533 B KC 2636 Oswego 2774  
 Bart. 2933 Miss. 3075  
 TD 3086 5" @ 2986 GO to 2986  
 12/2946-48 SW S/5 BO 1/2 BWPB  
 Comp. 25 BOPD 10 BW

**COMPLETED**



