
DX 78-1

Barton KANSAS

Section 35 Township 19 Range 15W

Well No. #1 Merten

Company W.L. Hartman & J. L. Atkinson, etal

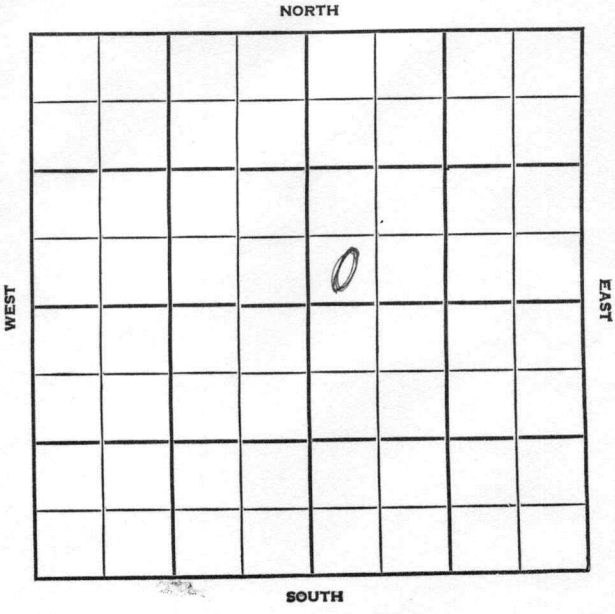

FORM 513 SUNRAY

WILDCAT

County Barton Elev. 1918

Sec. 35 Twp. 19 Rge. 15W

Company W. L. Hartman

Farm Name Merten No. 1

TOPS	DEPTH	LOG	DATUM
Anh.			
Tp.			
H.			
Tr.			
Dg.			
Bl.			
L.			
K.C.			
B.K.C.			
Ce.			
C.			
M.			
M.			
K.			
Mz.			
Mo.			
V.			
S.			
S.			
A			
R.			
P€.			
G.			
T.D.			

Loc. in Sec. SW SW NE

Geol.

Contr. H. & H. Tools

Pool ½ mi. W.C.



Date Comm. RURT

Co. Lse. No. Sec. T. R.

FORM 513 SUNRAY

County Barton Elev. 1918

Sec. 35 Twp. 19 Rge. 15W

Company W. L. Hartman & I.F. Atkinson et al

Farm Name Merten No. 1

TOPS	DEPTH	LOG	DATUM
Anh.	869		
Tp.			
H.	3188		
Tr.	3202		
Dg.	3216		
B.L.	3273		
L.	3284		
K.C.			
B.K.C.	3518		
Ce.			
C.	3541		
M.			
M.			
K.			
Mz.			
Mo.			
V.			
S.			
S.			
A	3599		
R.			
P€.			
G.			
T.D.	3674		

Loc. in Sec. SW SW NE

Geol.

Contr. H. & H. Tool

Pool

½ mi. W.C.



Date Comm.

RURT NOV 26 '56 11-21-56 8-78

877/400 Ø 2509 DEC 5 '56

DST 3412-27 1hr rec 25' MSW BHP 970 DST 3599-3604 1hr rec 18' WM BHP 0 DST 3604-15 DEC 12 '56 op 1hr rec 9' Md BHP 220

O & A