


Section 35 Township 19 Range 15WWell No. #1 MertenCompany Schermerhorn Oil

NORTH

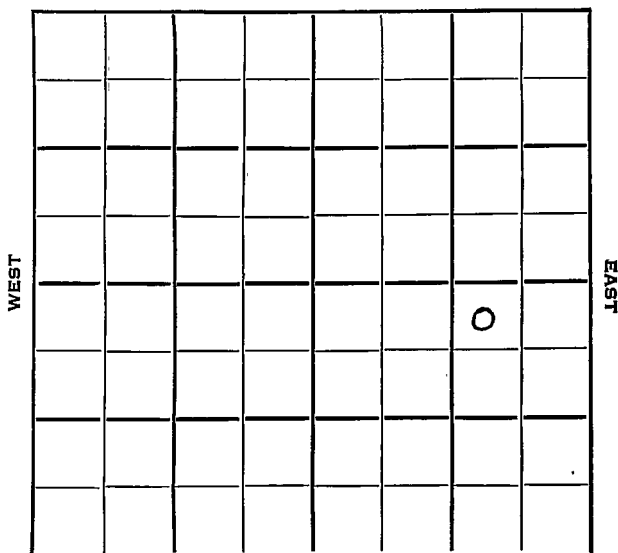

SOUTH

Sec. 35 Twp. 19 R. 15W

Well No. #1 Merten Farm

Schermerhorn Oil Company

Badger Contractor

Wildcat.


330 Ft. from N. Line

 Ft. from S. Line

990 Ft. from E. Line

 Ft. from W. Line

NW NE SE

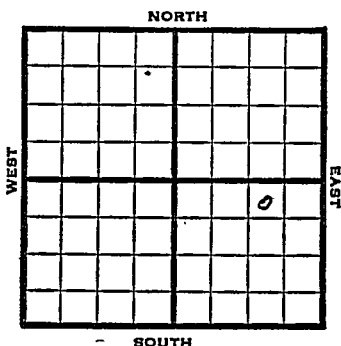

1953

Elev. 1930' REPORT

4/29 M I R

5/7 Anhy 894'

8" @ 899'

Drlg 1891'

5/21 NR

5/28 "

6/3 NR

9/30 Spud 4-30-53 Oil well TD 3541
Anhy 894 8" @ 899 Tarkio 2631'
Willard 2658 Elmont 2692 Howard
2830' Top. 2903 Heeb 3152
Tor. 3166 Doug. 3178 Br lime 3235
Lans 3246
DST 3247-67 open 1 hr rec 61' HOCM
360#
DST 3267-3302 open 1 hr rec 1000' gas
200' HOCM, 130' gassy oil 1140#
DST 3309-16 open 1 hr rec 275' gas,
50' GCO, 95' sul wtr. 1280#
DST 3303-08 open 1 hr rec 60' gas,
30' OCM, 110#
DST 3362-90 open 1 hr rec 120' O &
GCM 320#
DST 3463 failed.
DST 3392-3410 open 1 hr rec 360' wtr.
1160#

OVER

1953
9/30

(Information continued)

DST 3514-27 open 1 hr rec 35' SO &

GCM 340# TD 3541 5" @ 3541

Regan 3509 reCamb. 3529


CO to 3541 18/3269-72 300 A wtr.

SP 3340 56/3291-95 500 A

S/8 BOPH P/13 BOPD

Comp. 5 BOPD

COMPLETED

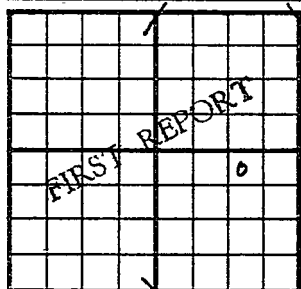County Barton State KansasSec. 35 (Blk. 10) (Sur. Rge.) 15W Map No. _____Operator Schermerhorn OilWell No. 1 Farm MertenElev. _____ Location NW NE SE330 Ft. From N Line SE990 Ft. From E Line Quarter1st. Report APR 29 1953

Completion _____


Remarks _____

Badger - Contr.

Spudding Date _____

Drlg. Data WildcatM I R

County Barton State Kansas
 Sec. 35 (Blk. 19 (Sur. 15W Map No.)
 Operator Schermerhorn Oil
 Well No. 1 Farm Merten
 Elev. 1930 Location NW NE SE

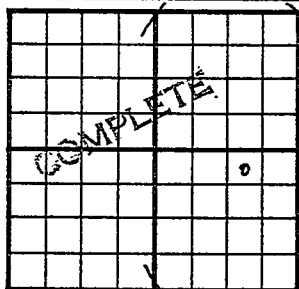

330 Ft. From N Line SE
990 Ft. From E Line Quarter

1st. Report
SEP 30 1953
Completion

Remarks Wildcat
Badger - Contr.

Spudding Date 4-30-53
Oil well TD 3541

Drlg. Data

Anhy 894 8" @ 899 Tarkio 2631
Willard 2658 Elmont 2692 Howard 2830
Top. 2903 Heeb. 3152 Tor. 3166
Doug. 3178 Br. lime 3235 Lans. 3246
DST 3247-67 open 1 hr. Rec. 61' hocom
360# DST 3267-3302 open 1 hr. Rec.
1000' gas 200' hocom 130' gassy oil
1140# DST 3309-16 open 1 hr. Rec.
275' gas 50' gco 95' sul. wtr. 1280#
DST 3303-08 open 1 hr. Rec. 60' gas
30' ocm 110# DST 3362-90 open 1 hr.
Rec. 120' o & gcm 320# DST 3463 failed
DST 3392-3410 open 1 hr. Rec. 360' wtr.
1160# DST 3514-27 open 1 hr. Rec. 35'

J. G. McGEHEE

Drlg. Data

so & gcm 340# TD 3541 5" @ 3541

Regan 3509 PreCamb. 3529 CO to 3541

18/ 3269-72 300 A wtr. SP 3340

56/ 3291-95 500 A S/ 8 boph

P/ 13 bopd Comp. 5 bopd

Scout Cards
Land Small Map
Land Wall Map
Tracings
France Map
Pierce Map
Misc.

8/15/53

8

Oct 1953