


Section 35 Township 32 Range 4E

Well No. 4 Harris

Company C. A. Black

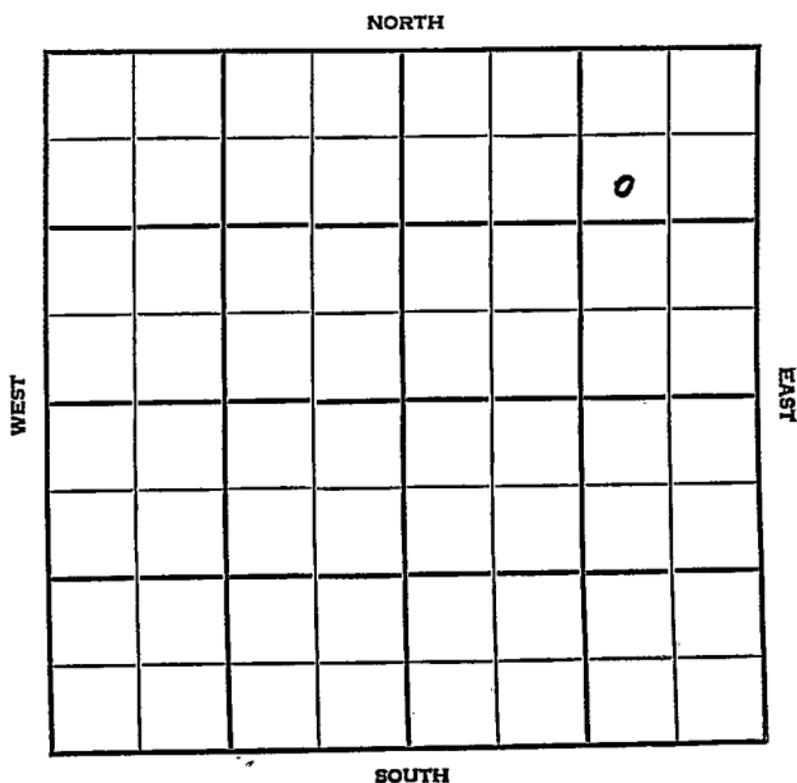

Cowley

KANSAS

SEC.	TWP.	R.
35	32	1E

WELL NO. _____

COMPANY #4 Harris FARM

CONTRACTOR C.A. Black

Wakefield.


Winfield Pool

990 Ft. from N. Line

_____ Ft. from S. Line

990 Ft. from E. Line

_____ Ft. from W. Line

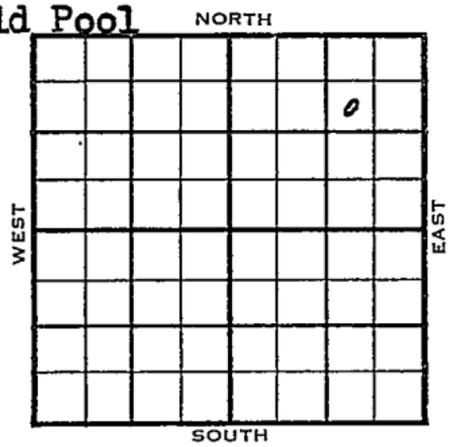

SW NE NE

	ELEVATION	REPORT
1955	1196'	
2/16	Spud 2-7-55	
	8" @ 140'	
	Drlg. 1795'	
3/2	Spud 2-7-55	Oil well TD 2940
	8" @ 140'	Peacock 1625' Hoover
	1775' Stal. 1895'	Layton 2362
	KC 2513' Oswego 2709'	Bart 2919
	Bart sd 2928'	TD 2933
	5" @ 2933	DD 2940 PB 2938 frac.
	Comp. 25 BOPD	
	COMPLETED	

