

Company Schermerhorn Oil Corp.

A 10x10 grid with 'NORTH' at the top, 'SOUTH' at the bottom, 'WEST' on the left, and 'EAST' on the right. A single '0' is in the 7th row from the top and 8th column from the left.

Barton
19

KANSAS ✓

Sec. 35 Twp. 19 R. 15W

Well No. #2 Merten Farm

Schermerhorn Oil Corp. Company

Badger Drlg. Contractor

Ft. from N. Line


NORTH

990 Ft. from S. Line

990 Ft. from E. Line

Ft. from W. Line

NW SE SE

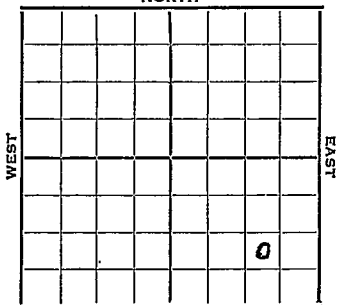

SOUTH

1953 Elev. 1929' REPORT

7/11 Spud 7-7-53
8" @ 887 w/425
Anh 883
Drlg. 2273'

7/22 Heeb 3160, Tor 3174, Doug 3188, Br li
3244, Lans 3257
DST 3257-3300, 1 hr., 30' m, 920#
DST 3316-24, 1 hr., 70' M & W, 1220#
DST 3298-3318, 1 hr., 20' M & W
Drlg. 3440'

7/29 Spud 7-7-53 D & A TD 3558'
8" @ 887 Anhy 883 Heeb 3160
Tor. 3174 Doug. 3188 Br lime 3244
Lans 3257
DST 3257-3300 open 1 hr rec 30' mud
920#
DST 3316-24 open 1 hr. rec 70' mud &
wtr. 1220#
DST 3298-3318 open 1 hr rec 20' mud
& wtr. B KC 3486 PreCamb 3553
TD 3558
D & A

ABANDONED

J. G. McGEHEE

County	Barton		State	Kansas	
Sec.	35	(Blk. Twp.) 19	(S ^{ur} . R ^{ge} .) 15W	Map No.	
Operator	Schermmerhorn Oil Corp.				
Well No.	2	Farm	Merten		
Elev.	1929	Location	NW SE SE		

ABANDONED

990 Ft. From	S	Line	SE
990 Ft. From	E	Line	Quarter

1st. Report

Completion JUL 29 1953

Remarks

Badger - Contr.

Spudding Date 7-7-53

Drlg: Data D & A TD 3558
 8" @ 887 Anhy 883 Heeb. 3160
 Tor. 3174 Doug. 3188 Br. lime 3244
 Lans. 3257 DST 3257-3300 open 1 hr.
 Rec. 30' mud 920# DST 3316-24
 open 1 hr. Rec. 70' mud & wtr. 1220#
 DST 3298-3318 open 1 hr. Rec. 20' mud
 & wtr. B KC 3486 PreCamb. 3553
 TD 3558

D & A.

J. G. McGEHEE