

Barton KANSAS


SEC.	TWP.	R.
36	19	15W ✓

WELL NO. 1 Murten "A" FARM

COMPANY Schermerhorn Oil

CONTRACTOR Badger

990 Ft. from N. Line
 Ft. from S. Line
 Ft. from E. Line
 330 Ft. from W. Line

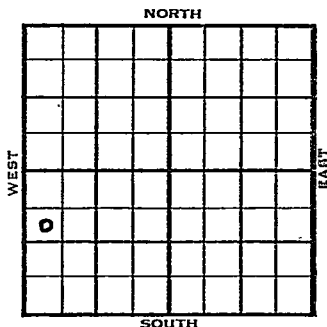

SW NW SW

1954	ELEVATION	REPORT
	1936'	

3/31 Spud 3-28-54
 Drlg. 907'

4/7 Anhy 884'
 8" @ 885'
 Drlg. 2830'

5/19 Spud 3-28-54
 Oil Well
 TD 3562'
 Anhy 884'
 8" @ 885'
 Heeb 3161', Doug 3187', Br. Lime 3243'
 Lans 3255',
 DST 3246'-3302' opn 1 hr, rec 120' gas
 90' hocm, 170#
 DST 3301'-17' opn 1 hr, rec 30' socm
 O#
 DST 3378'-3400' opn 1 hr, rec 10' Mud
 810#
 B KC 3488'
 DST 3470'-3520' opn 1/2 hr, rec 15' Mud O#
 Qtz. 3548'
 TD 3562'
 5" @ 3551'
 CO to 3550 38/ 3543-48 FU 1100' oil
 2 hr. S/ 27 bo 1 1/2 hr. Comp 198 bopd.
 Reagan 3534'

COMPLETED

County Barton State Kansas

Sec. 36 (Blk. Twp.) 19 (Sur. Rge.) 15W Map No.

Operator Schermerhorn Oil

Well No. 1 Farm Murten "A"

Elev. Location SW NW SW

FIRST REPORT									

990 Ft. From N Line SW

330 Ft. From W Line Quarter

1st. Report MAR 31 1954

Completion

Remarks

Badger - Contr.

Spudding Date 3-28-54

Drig. Data

drig. 907

