
DX 78-1

Cowley KANSAS

Section 36 Township 32 Range 4E

Well No. 1 Denny

Company L. C. Smitherman

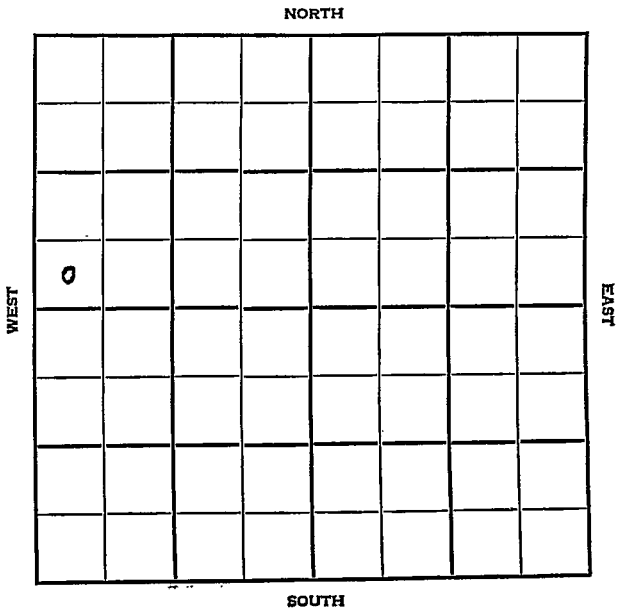

Cowley KANSAS

SEC.	TWP.	R.
36	32	4E ✓

WELL NO. #1 Denny FARM

COMPANY L.C. Smitherman

CONTRACTOR Smitherman

Winfield Pool


_____ Ft. from N. Line

330 Ft. from S. Line

_____ Ft. from E. Line

330 Ft. from W. Line

SW SW NW

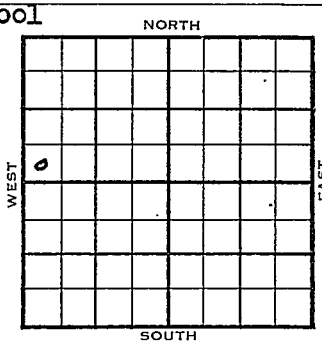

	ELEVATION 1214' REPORT
1954	
5/12	Spud 5-5-54 8" @ 150' Drlg 2735'
6/9	Spudding 5-5-54 D & A TD 2964 8" @ 150 Severy Sd. 1422 Peacock 1480 Stall936 Layton 2374 KC 2535 Oswego 2736 Cherokee 2850 Bart 2952 DST 2952-64 open 2 hr. Rec. 500' gas 150' fluid 100' oil 30' sw 1030# TD 2964 5" @ 2952 CO to 2964 SW PB 2960 HFW D &A

ABANDONED

DX-78

FORM 275 FOR SALE BY KANSAS BLUE PRINT CO.


County Cowley State Kansas

Sec. 36 (Blk. Twp.) 32 (Sur. Rge.) 4E Map No.

Operator L. C. Smitherman

Well No. 1 Farm Denny

Elev. 1214 Location SW SW NW

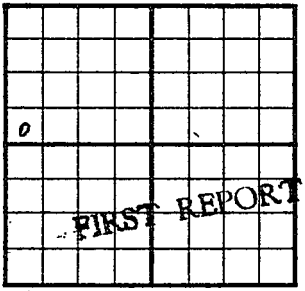

330 Ft. From S Line NW

330 Ft. From W Line Quarter

1st. Report MAY 12 1954

Completion

Remarks Smitherman - Contr.

Spudding Date 5-5-54

Drlg. Data Winfield Pool

8" @ 150 drlg. 2735

J. G. McGEHEE

FORM 275 FOR SALE BY KANSAS BLUE PRINT CO.


County Cowley State Kansas

Sec. 36 (Blk. Twp.) 32 (Sur. Rge.) 4E Map No.

Operator L. C. Smitherman

Well No. 1 Farm Denny

Elev. 1214 Location SW SW NW

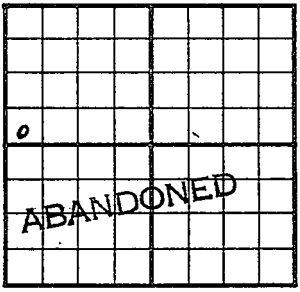

330 Ft. From S Line NW

330 Ft. From W Line Quarter

1st. Report

Completion JUN 9 1954

Remarks Winfield Pool
Smitherman - Contr.

Spudding Date 5-5-54

Drlg. Data D & A TD 2964

8" @ 150 Severy sd. 1422 Peacokk 1480

Stal. 1936 Layton 2374 KC 2535

Oswego 2736 Cherokee 2850 Bart. 2952

DST 2952-64 open 2 hr. Rec. 500' gas
150' fluid 100' oil 30' sw 1030#

TD 2964 5" @ 2952 CO to 2964 SW

PB 2960 HFW

D & A

J. G. McGEHEE