

DX 78-1

Rush


KANSAS

Section 7 Township 19S Range 16W

Well No. #1 Hagerman

Company Woodman & Iannitti

16

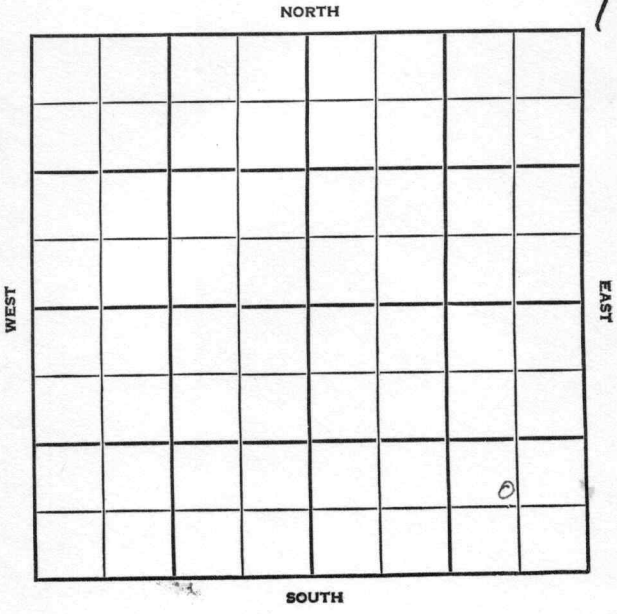

Rush

KANSAS

SEC. 7	TWP. 19	R. 16W
-----------	------------	-----------

WELL NO.

#1 Hagerman

FARM

COMPANY

Woodman & Iannitti

CONTRACTOR

Co.

WILDCAT


_____ FT. FROM N. LINE

_____ FT. FROM S. LINE

_____ FT. FROM E. LINE

_____ FT. FROM W. LINE

SE NW SE SE

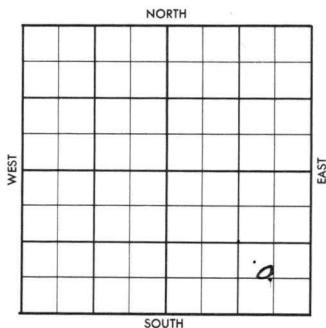

1956

ELEVATION

2103'

REPORT

8-8

WORT

8-22

Comm. 8-6-56

8 5/8" @ 321

DST 3835-48 op 30 min. rec. 8' mud,
BHP 0/10".DST 3853-63 op 30 min. rec. 2 gal. mud
BHP 0/10".DST 3863-76 op 30 min. rec. 18' mud,
BHP 320/10".

RTD 3890'

No Log.

D&A

H. 3446'; L. 3508'; C. 3834';

A. 3852';

TD 3890'

ABANDONED

County Rush Elev. 16W
 Sec. 7 Twp. 19S Rgs. 16W
 Company Woodman & Iannitti
 Farm Name Hagerman No. 1

TOPS	DEPTH	LOG	DATUM	Loc. in Sec.
Anh.				SE NW SE SE
TP.				
H.				
Tr.				
Dg.				
BL.				
L.				Geol.
K.C.				Contr.
B.K.C.				Co.
Ce.				
C.				
M.				
M.				Pool
K.				W. C.
Mz.				
Me.				
V.				
S.				
S.				
A.				
R.				
PE.				
G.				
T.D.				

FIRST REPORT

Date Comm. WORT AUG 8 '56

(Faint mirrored text: 2201 2 1 2004)

(Large handwritten mark: 14)

(Faint handwritten text: H.C.)

Co.
Lse.
No.
Sec.
T.
R.

Co.

County Rush Elev. 2103
 Sec. 7 Twp. 19S Rge. 16W
 Company Woodman & Iannitti
 Farm Name Hagerman No. 1

TOPS	DEPTH	LOG	DATUM	Loc. in Sec.
Anh.				SE NW SE SE
Tr.				
H.	3446			
Tr.				
Dg.				
BL.				
L.	3508			Geol.
K.C.				Concr.
B.K.C.				
Ce.				Co.
C.	3834			
M.				Pool
M.				W. C.
K.				<div style="border: 1px dashed black; padding: 5px; text-align: center;"> ABANDONED </div>
Me.				
V.				
S.				
S.	3852			
A.				
R.				
PE.				
G.				
TD.	3890			

Lse.

No.

Sec.

T.

R.

AUG 22 1956

Date Comm. WORT AUG 15 '50 8-6-56 85/8
321 3515 AUG 22 '56 X C9.
3834 DST 3835-48 op 30" res
8' Md BHP 0/10" Arb 3852 DST
3853-63 op 30" res 2 Gall. Md
BHP 0/10" DST 3863-76 op 30" res
18' Md (seum oil) BHP 320/10" RTD
3890 No Log.
DEA Rig to 1st Res.