


Map No. **KANSAS** Sec. **4** Twp. **31** R. **8**
Well No. **4** **Ferguson** **Denton** Farm
Minnehoma & Murphy Company

NORTH

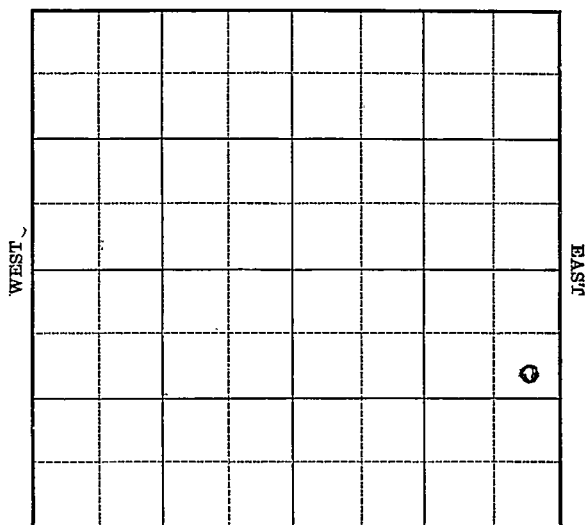

SOUTH

Location_____

Drilling Remarks

Rig Up

Drilling Remarks

RECORD

Cased_____in. _____ft.

Sand _____

Gas

Oil

Total Depth_____

PRODUCTION

1st 24 hrs. Nat. _____

1st 24 hrs. after shot_____

Gas _____ cu. ft.

Dry Hole_____

Abandoned -----


Map No. **KANSAS** Sec. **4** Twp. **31** R. **8**
 Well No. **4** **Denton** Farm
Minnehoma ^{Hwy} **Murphy** Company

1070 Ft. from N. Line

_____ Ft. from S. Line

250 Ft. from E. Line

_____ Ft. from W. Line

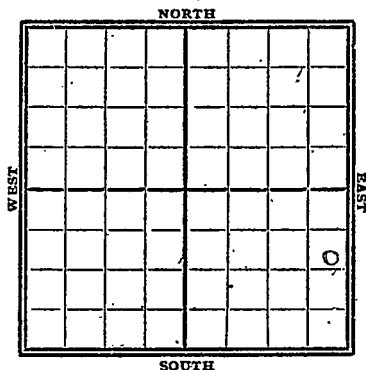

1928

Date

REPORT

7/25 **Loc**

8/9 _____

8/16 _____

8/23 _____

8/28 _____

9/4 _____

9/12 _____

9/19 _____

9/26 _____

10/3 _____

10/10 _____

10/17 _____

10/24 _____

10/31 _____

11/7 _____

11/14 _____

11/21 _____

11/28 **Rigging up**

12/5 _____

12/12 **Spd g.**

12/19 **Drill 400'**

12/26 **" 400'**

1929

1/2 - drlg 900'

1/9 - S.D. 900'

REMARKS

1/16 - drlg 1050'

1/23 - T.D. 1250' UIR 1100'

1/30 - UIR 1250 T.D.

2/6 - T.D. 1500' UIR 10"-1295'

2/13

2/20 - drlg 1800'

2/27 - fig tools 1865'

3/6

3/13

3/20

3/27

4/3

4/10

4/17

4/24

5/1 - T.D. 1865' - hole clean

5/8

5/15

5/22 - S.D. 1865'

5/29

6/5

6/12

6/19

6/26

7/2

7/10

7/17

7/24 - S.D. 1875'

7/31 - set 5" - 1900'

1929

8/7 - sand 1965-86

T.D. 1986'

100 bbls. oil

34° gravity

Cowley

3 KANSAS SEC. 4 TWP. 31 R. 8

WELL NO. 11 Zerkowson Denton

Minne koma O. Murphy COMPANY

CONTRACTOR

FIRST REPORTS

SECTION PLAT

1070 Ft. FROM N. LINE

Ft. FROM S. LINE

250 Ft. FROM E. LINE

Ft. FROM W. LINE

			0

LOCATION ✓

RIG UP

DRILLING AND REMARKS:

RECORD

CASED IN. FT.

SAND

GAS

OIL

TOTAL DEPTH

PRODUCTION

1ST 24 HRS. NAT.

1ST 24 HRS. AFTER SHOT

GAS Cu. Ft.

DRY HOLE

ABANDONED

DATE

JUL 25 1928

CHAS. L. SHERWOOD

SCOUT

3
 Map No. KANSAS Sec. 4 Twp. 31 R. 8
 Well No. 4 Ferguson Denton
Winneboha & Murphy Company
 Contractor

COMPLETE

SECTION PLAT

1070 Ft. from N. Line
 _____ Ft. from S. Line
250 Ft. from E. Line
 _____ Ft. from W. Line

			o

Location _____

Rig up _____

Drilling and Remarks _____

100 Bl

3 1/4 Sides

RECORD

Cased _____ in., _____ ft.

Sand 1965-1986

Gas _____

Oil _____

Total Depth 1986

PRODUCTION

1st 24 hrs. Nat. _____

1st 24 hrs. after shot _____

Gas _____ Cu. Ft.

Dry Hole _____

Abandoned _____

Date
 AUG 7 1929

CHAS. L. SHERWOOD

Scout