


Map No. 25 Sec. 4 Twp. 31 R. 8

Well No. 1 - Denton Farm
Murphy & Minnehoma Company

_____ Ft. from N. Line
250 Ft. from S. Line
250 Ft. from E. Line
 _____ Ft. from W. Line

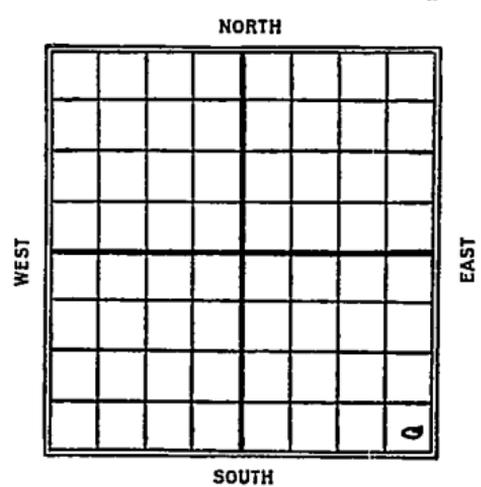

1926

Date	REPORT
11/17	Drly 500
11/23	" 1300'
12/8	" 1300
12/15	S.D. 1850'
12/22	and 1996-2007 made 49 bbls 3 hrs Est 25 bbls
12/30	and 1996-2007 25 bbls natural T.D. 2007
1930	OWDD
5/28	Old T.D. 2007 Regrin up
6/4	—
6/11	—
6/18	Frq. 2030'
6/25	—
7/2	— 8/13 —
7/9	— 8/20 —
7/16	— 8/27 —
7/23	— 9/3 —
7/30	— 9/10 —
8/6	— 9/17 T.D. 2030 Abandoned

Cowley

Map No. **KANSAS** Sec. 4 Twp. 31 R. 8^E

Well No. 1 *Denton*
Murphy *Minnehoma* Company

Contractor

FIRST REPORTS

SECTION PLAT

_____ Ft. from N. Line

750 Ft. from S. Line

750 Ft. from E. Line

_____ Ft. from W. Line

			0

"old well deeper"

Location _____

RECORD

Rig up _____

Cased _____ in., _____ ft.

Drilling and Remarks:

Sand _____

JD 2007

Gas _____

Rgw up

Oil _____

Total Depth _____

PRODUCTION

1st 24 hrs. Nat. _____

1st 24 hrs. after shot _____

Gas _____ Cu. Ft.

Dry Hole _____

Abandoned _____

Date
 MAY 28 1930

CHAS. L. SHERWOOD

Cowley

3 **KANSAS** Map No. _____ Sec. 4 Twp. 31 R. 8

Well No. 1 *Denton*

Murphy *Minnehoma* Company

Contractor _____

COMPLETE

SECTION PLAT

_____ Ft. from N. Line

750 Ft. from S. Line

750 Ft. from E. Line

_____ Ft. from W. Line

ABANDONED

			0

Location _____

Rig up _____

Drilling and Remarks:

RECORD

Cased _____ in., _____ ft.

Sand _____

Gas _____

Oil _____

Total Depth 2030

PRODUCTION

1st 24 hrs. Nat. _____

1st 24 hrs. after shot _____

Gas _____ Cu. Ft.

Dry Hole

Abandoned

Date

SEP 17 1930

CHAS. L. SHERWOOD

19

Scout

Cowley
31 R. 8

3 KANSAS Map No. Sec. 4 Twp. 31 R. 8

Well No. 1 Denton

Murphy & Hinnehom Company

Contractor

FIRST REPORTS

SECTION PLAT

_____ Ft. from N. Line
250 Ft. from S. Line
250 Ft. from E. Line
_____ Ft. from W. Line

			o

Location _____

Rig up _____

Drilling and Remarks:

Only 500'

RECORD

Cased _____ in., _____ ft.
Sand _____
Gas _____
Oil _____
Total Depth _____

PRODUCTION

1st 24 hrs. Nat. _____
1st 24 hrs. after shot _____
Gas _____ Cu. Ft.
Dry Hole _____
Abandoned _____

Date NOV 17 1926

CHAS. L. SHERWOOD

192 Scout

Cowley

3 KANSAS Map No. Sec. 4 Twp. 31 R. 8

Well No. 1 *Denton*

Murphy & Hinckley Company Contractor

COMPLETED

SECTION PLAT

_____ Ft. from N. Line

250 _____ Ft. from S. Line

250 _____ Ft. from E. Line

_____ Ft. from W. Line

			0

Location _____

Rig up _____

Drilling and Remarks:

25 lbs water

RECORD

Cased _____ in., _____ ft.

Sand *1996-2007*

Gas _____

Oil _____

Total Depth *2007*

PRODUCTION

1st 24 hrs. Nat. _____

1st 24 hrs. after shot _____

Gas _____ Cu. Ft.

Dry Hole _____

Abandoned _____

Date

DEC 30 1926.

CHAS. L. SHERWOOD

192

Scout