


Section 3 Township 31 Range 8E

Well No. #1 Furgeson (Ferguson)

Company Tyrell & Wilson

NORTH

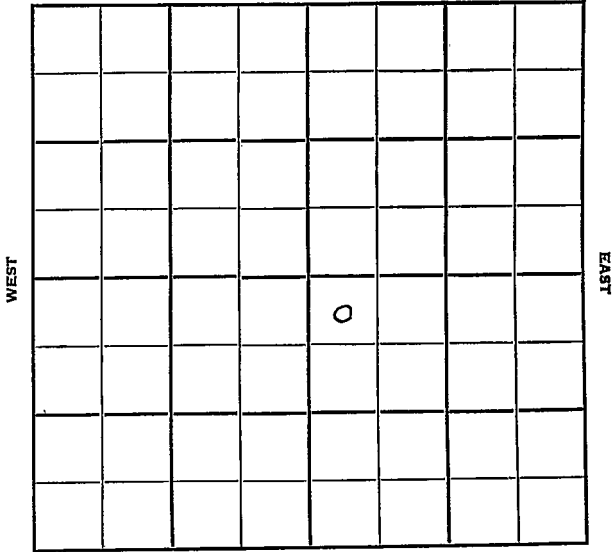

SOUTH

Elk

KANSAS

Sec. 3 Twp. 31 R. 8E

Well No. #1 Furgeson Farm

Tyrell & Wilson Company

Contractor


330' Ft. from N. Line

_____ Ft. from S. Line

_____ Ft. from E. Line

330' Ft. from W. Line

NW NW SE

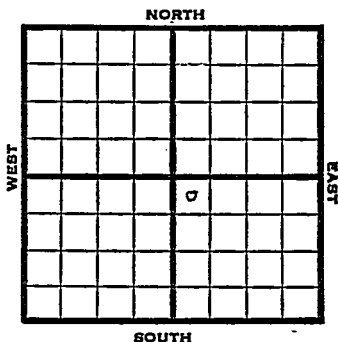

1951

Elev. 1404' REPORT

4/4

D&A TD 3052

Wildcat

Iton 1463'

Lans. 1500'

Layton 1908'

KC 1952

BKC 2158'

Oswego 2362

Cherokee sh 2410'

Burgess sd 2700' Miss 2702'

Arb. 3019'

TD 3052

D&A

FIRST REPORT

ABANDONED

