

Adgwick

Map No. _____ Sec. 20 Twp. 28 R. 1E

Well No. 3 - Lohkamp Farm _____

Dickey Oil Company _____


_____ Ft. from N. Line

330 Ft. from S. Line

_____ Ft. from E. Line

990 Ft. from W. Line

Elevation 1271

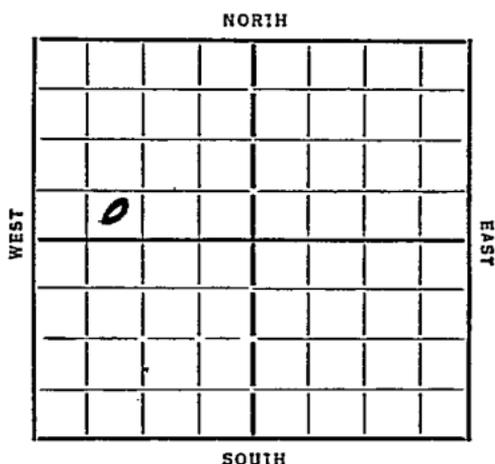

Date 7/35

REPORT

7/10 Location _____

7/18 Rgn _____

8/8 TIC 3087 6" 3090 T73017

8/14 Chat 3087 T7 3116

2000 acid 226 Pbls.

COMPLETED

Map No. 12 Sec. 20 Twp. 28 R. 1 E

Well No. 3-Lohkamp

Wicky oil

Company

Contractor

FIRST REPORTS

SECTION PLAT

..... Ft. from N. Line

330 Ft. from S. Line

..... Ft. from E. Line

990 Ft. from W. Line

	0		

Location

Rig up.....

Drilling and Remarks:

RECORD

Cased..... in., ft.

Sand.....

Gas.....

Oil.....

Total Depth.....

PRODUCTION

1st 24 hrs. Nat.....

1st 24 hrs. after shot.....

Gas..... Cu. Ft.

Dry Hole.....

Abandoned.....

Date

7-10-35 192.....

ORVAL MANNSCHRECK

Scout

Map No. 12 Sec. 20 Twp. 28 R. 1 E

Well No. 3-Lohkamp

Dickey Oil Company

Contractor

COMPLETED

SECTION PLAT

0			

Ft. from N. Line

330 Ft. from S. Line

Ft. from E. Line

990 Ft. from W. Line

Location.....

Rig up.....

Drilling and Remarks:

2000 air

226 lbs

RECORD

Cased in. ft.

Sand Chat 3087

Gas.....

Oil.....

Total Depth 3116

PRODUCTION

1st 24 hrs. Nat.....

1st 24 hrs. after shot.....

Gas..... Cu. Ft.

Dry Hole.....

Abandoned.....

Date

ORVAL MANNSCHRECK

8-14-35 192

Scout