

Sedgwick


Map No. *KANS.* Sec. *20* Twp. *28* R. *1E*

Well No. *2- Lohkamp* Farm

Dickey Oil

Company

NORTH

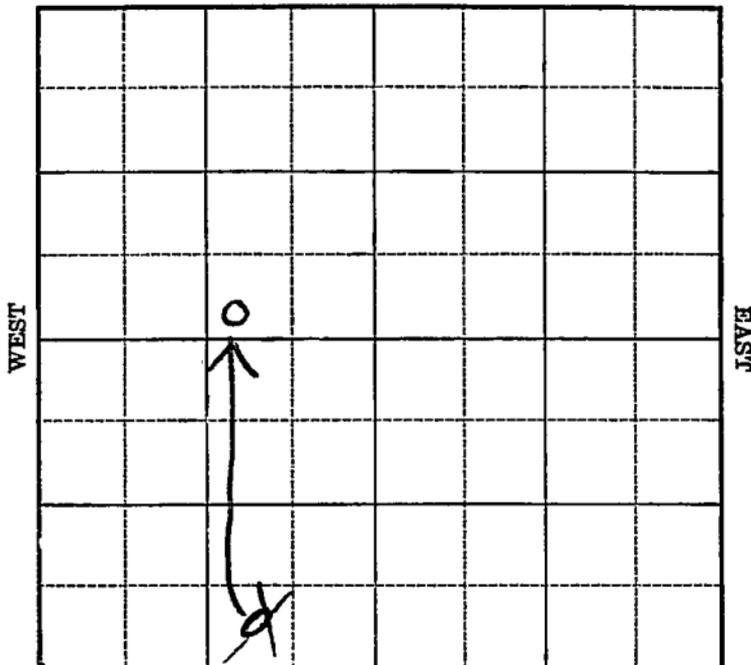

SOUTH

Location _____

Drilling Remarks _____

Rig Up _____

Drilling Remarks _____

RECORD

Cased _____ in. _____ ft.

Sand _____

Gas _____

Oil _____

Total Depth _____

PRODUCTION

1st 24 hrs. Nat. _____

1st 24 hrs. after shot _____

Gas _____ cu. ft.

Dry Hole _____


Abandoned _____

Selgwick

Map No. KANSAS Sec. 20 Twp. 28 R. 1E

Well No. 2- Lohkamp Farm _____
Dickey Oil Company _____

_____ Ft. from N. Line
330 Ft. from S. Line
990 Ft. from E. Line
_____ Ft. from W. Line

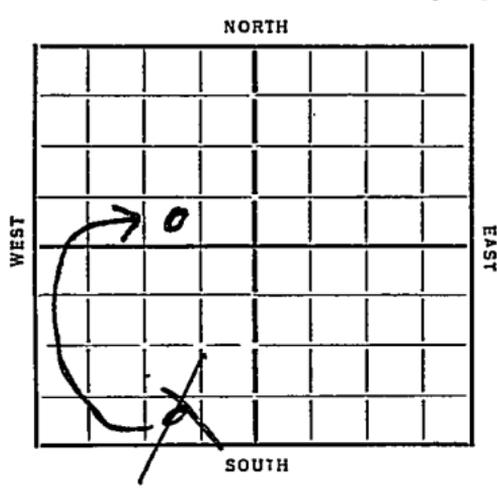

Date 1935

REPORT

4/17 Cellar
4/26 10" 85 WOC
5/2 dy 2675
5/9 T @ 3090 T 17 3094 6" 3090
5/16 3118 T 17 1000 acid
5/22 T ML 3090 T 17 3118
1000 acid 575 Bbls.

COMPLETED

Map No. 12 Sec. 20 Twp. 28 R. 1E

Well No. 2 - Lohkamp


Company

Contractor

FIRST REPORTS

SECTION PLAT

	0		

..... Ft. from N. Line

330 Ft. from S. Line

990 Ft. from E. Line

..... Ft. from W. Line

Location.....

Rig up.....

Drilling and Remarks:

cellar

RECORD

Cased..... in., ft.

Sand.....

Gas.....

Oil.....

Total Depth.....

PRODUCTION

1st 24 hrs. Nat.....

1st 24 hrs. after shot.....

Gas..... Cu. Ft.

Dry Hole.....

Abandoned.....

Date

4-17-35

192

ORVAL MANNSCHRECK

Scout

KANSAS

Map No. 12 Sec. 20 Twp. 28 R. 1E

Well No. 2-Lohkamp

Dickey oil

Company

Contractor

CORRECTION

SECTION PLAT

	0		

..... Ft. from N. Line

330 Ft. from S. Line

990 Ft. from E. Line

..... Ft. from W. Line

CORRECTION

Location.....

Rig up.....

Drilling and Remarks:

*formerly Reported
as NW 1/4 SW*

RECORD

Cased.....in.,ft.

Sand.....

Gas.....

Oil.....

Total Depth.....

PRODUCTION

1st 24 hrs. Nat.....

1st 24 hrs. after shot.....

Gas..... Cu. Ft.

Dry Hole.....

Abandoned.....

Date

4-24-35 192

ORVAL MANSCHRECK

Scout

KANSAS

Map No. 12 Sec. 20 Twp. 28 R. 1E

Well No. 2-Lohkamp


Contractor

COMPLETED

SECTION PLAT

	0		

.....Ft. from N. Line

330 Ft. from S. Line

990 Ft. from E. Line

.....Ft. from W. Line

Location.....

Rig up.....

Drilling and Remarks:

1000 acid

575 lbs

RECORD

Cased..... in., ft.

Sand TML 3090

Gas.....

Oil.....

Total Depth 3118

PRODUCTION

1st 24 hrs. Nat.....

1st 24 hrs. after shot.....

Gas..... Cu. Ft.

Dry Hole.....

Abandoned.....

Date

5-28-35 192.....


Scout