




*Sedgwick*

Map No. 154NSA Sec. 70 Twp. 28 R. 1E

Well No. 1 Lockkamp Farm  
Rickey Oil Company

\_\_\_\_\_ Ft. from N. Line  
330 Ft. from S. Line  
330 Ft. from E. Line  
\_\_\_\_\_ Ft. from W. Line

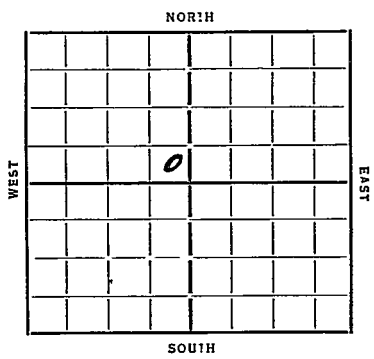

Date 12/34

REPORT

12/5 Cellar  
12/13 Rgn Lot.  
12/21 Wly 1730  
12/27 \_\_\_\_\_  
1/3/35 S.O. 2735 S.O. 2808 Chst 3083  
 6" 3083 Rust  
1/10 Chst 56" 3083  
1/16 Chst 3100 T.D. 3131  
 1000 acid 1443 Bble.

COMPLETED

KANSAS

Map No. 12 Sec. 20 Twp. 28 R. 15

Well No. 1 - Lockamp

Rickey Oil Company

Contractor

**FIRST REPORTS**

**SECTION PLAT**

..... Ft. from N. Line

330 Ft. from S. Line

330 Ft. from E. Line

..... Ft. from W. Line

	0		

Location.....

Rig up.....

Drilling and Remarks:

*cellar*

**RECORD:**

Cased..... in., ..... ft.

Sand.....

Gas.....

Oil.....

Total Depth.....

**PRODUCTION**

1st 24 hrs. Nat.....

1st 24 hrs. after shot.....

Gas..... Cu. Ft.

Dry Hole.....

Abandoned.....

Date

12-5-37

192.....

**ORVAL MANNSCHRECK**

Scout

Map No. 12 Sec. 20 Twp. 28 R. 1E

Well No. 1-Lohkamp

Dirty oil Company.

Contractor

**COMPLETED**

**SECTION PLAT**

		0	

.....Ft. from N. Line

330 Ft. from S. Line

330 Ft. from E. Line

.....Ft. from W. Line

**RECORD**

Location.....

Cased.....in.....ft.

Rig up.....

Sand Chat 3100

Drilling and Remarks:

Gas.....

1000 and

Oil.....

1443 lbs

Total Depth 3131

**PRODUCTION**

1st 24 hrs. Nat.....

1st 24 hrs. after shot.....

Gas.....Cu. Ft.

Dry Hole.....

Abandoned.....

Date

**ORVAL MANNSCHRECK**

1-16-37 192

Scout