


Section 26 Township 32 Range 4EWell No. 3 ThirskCompany E. F. Wakefield

NORTH

WEST

EAST

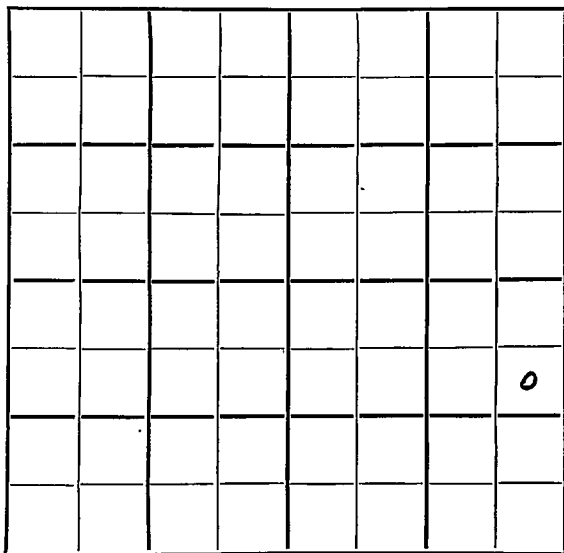

SOUTH

Cowley

KANSAS

SEC.	TWP.	R.
26	32	1 E ✓

WELL NO.

# 3 Thursk	FARM
------------	------

COMPANY

E. F. Wakefield


CONTRACTOR

990 Ft. from N. Line

Ft. from S. Line

330 Ft. from E. Line

Ft. from W. Line

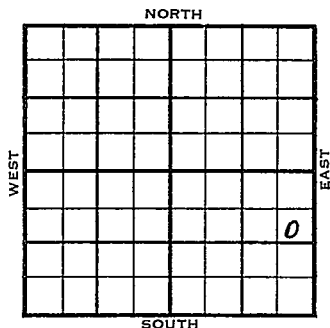

SE NE SE

	ELEVATION	REPORT
1954	1180'	

3/31


Location

4/28

Spud 4-2-54 Oil well TD 2902
 8" @ 50 Hoover 1710 Stal. 1916
 L. Stal. 2005 Layton 2336 KC 2499
 Bart. 2897 TD 2902 5" @ 2898
 CO to 2902 sd-frac. F/50 BOPH
 Comp. 25 BOPD

COMPLETED

County Cowley State Kansas
 Sec. 26 (Blk. 32 (Sur. 4E Map No.
 (Twp.) (Rge.)
 Operator E. F. Wakefield
 Well No. 3 Farm Thursk
 Elev. 1180 Location SE NE SE

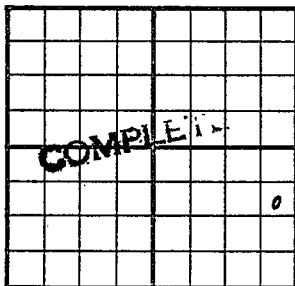

990 Ft. From N Line SE
330 Ft. From E Line Quarter

1st. Report

Completion APR 28 1954

Remarks

Spudding Date 4-2-54

Drlg. Data Oil well TD 2902
8" @ 50 Hoover 1710 Stal. 1916
L. Stal. 2005 Layton 2336 KC 2499
Bart. 2897 TD 2902 5" @ 2898
CO to 2902 sd-frac F/ 50 bopd
Comp. 25 bopd

J. G. McGEHEE