

DX 78-1

Cowley


KANSAS

Section 26 Township 32 Range 4 E

Well No. # 1 King

Company Bowman & Grissmore

NORTH

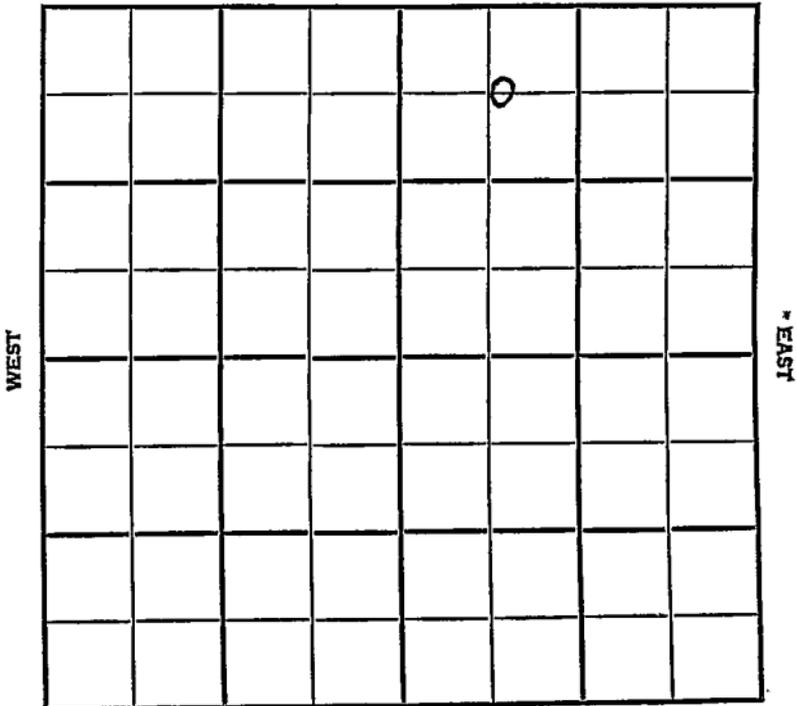

WEST

EAST

SOUTH

Cowley

KANSAS

SEC.	TWP.	R.
26	32	4E

WELL NO. #1 King FARM

COMPANY Bowman & Grissmore.

CONTRACTOR Springer & Harper.

Winfield Pool

600 Ft. from N. Line

Ft. from S. Line

1850 Ft. from E. Line

Ft. from W. Line

C NW NE

	ELEVATION	REPORT
1954	1190'	
12/22	Spud 12-12-54 8" @ 99'	Peacock Sd. 1462' Stal. 2016' Layton 2359'
1955		Drlg. 2719'
5/25		U. Hoover 1741; Pea Sd 1462; U. Stal 1916; Lay 2359; L. Stal 2136; K.C. 2525; Oswego 2722; Cattleman Sd 2954; TD 3013; 8" 99; 5" 2968; CO 2964; 24/2952-58, frac; 2 bopd lots wtr SWDW

COMPLETED

