

Hedgwick


Form 51-5M-5-34-Palace

Map No. KANSAS Sec. 17 Twp. 28 R. 1E

Well No. 4 Russell Farm

E. B. Shower Company

NORTH

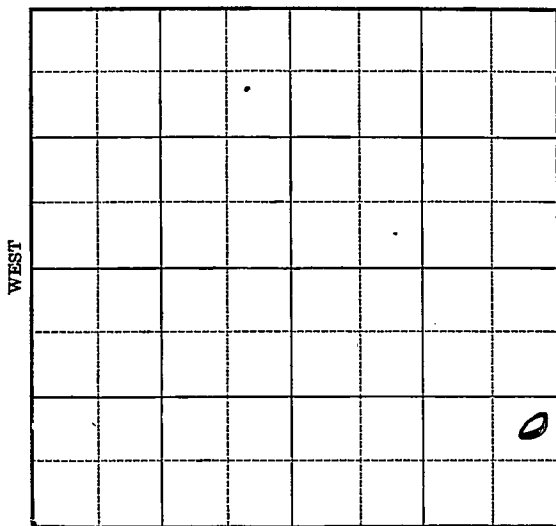

SOUTH

Location _____

Drilling Remarks _____

RECORD

Cased _____ in. _____ ft.

Sand _____

Gas _____

Oil _____

Total Depth _____

Rig Up _____

Drilling Remarks _____

PRODUCTION

1st 24 hrs. Nat. _____

1st 24 hrs. after shot _____

Gas _____ cu. ft.

Dry Hole _____


Abandoned _____

Sedgwick

Map No. KANSAS Sec. 17 Twp. 28 R. 1E

Well No. 4 Russell Farm
E. B. Shover Company

_____ Ft. from N. Line
990 Ft. from S. Line
330 Ft. from E. Line
_____ Ft. from W. Line

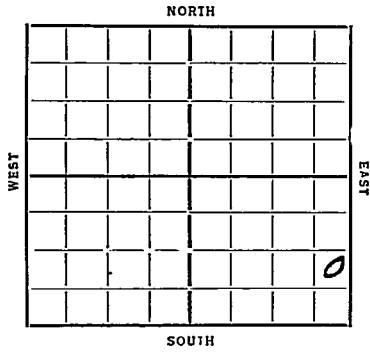

Date	REPORT
<u>10/31</u>	<u>Material</u>
<u>11/8</u>	<u>10" 91</u>
<u>11/15</u>	<u>Dly 2370</u>
<u>11/22</u>	<u>" 3074 TC 3071</u>
<u>11/28</u>	<u>S.O. 3082 Oil 3085-97</u>
	<u>2000' oil 3097-3106 HFO 3113</u>
<u>12/6</u>	<u>3117 TD Taking Potential</u>
<u>12/12</u>	<u>Chat 3085-3106 TD 3117</u>
	<u>1000 acid 355 Bbls.</u>

COMPLETED

Edgwick

Map No. 12 Sec. 17 Twp. 28 R. 1 E

Well No. 4 - Russell

E. B. Shawver Company

Contractor

FIRST REPORTS SECTION PLAT

_____ Ft. from N. Line

990 Ft. from S. Line

330 Ft. from E. Line

_____ Ft. from W. Line

			0

Location _____

Rig up _____

Drilling and Remarks:

Material

RECORD

Cased _____ in., _____ ft.

Sand _____

Gas _____

Oil _____

Total Depth _____

PRODUCTION

1st 24 hrs. Nat. _____

1st 24 hrs. after shot _____

Gas _____ Cu. Ft.

Dry Hole _____

Abandoned _____

Date

10-31-34 19

ORVAL MANNSCHRECK Scout

Map No. 12 Sec. 17 Twp. 28 R. 1E

Well No. 4-Russell
E. B. Shawnee Company

Contractor

COMPLETED

SECTION PLAT

* Ft. from N. Line

990 Ft. from S. Line

330 Ft. from E. Line,

Ft. from W. Line

Location.....

Rig up.....

Drilling and Remarks:

1000 acid

355 bbls

RECORD

Cased..... in., ft.

Sand Chat

Gas.....

Oil 3085-8706

Total Depth 3113

PRODUCTION

1st 24 hrs. Nat.....

1st 24 hrs. after shot.....

Gas..... Cu. Ft.

Dry Hole.....

Abandoned.....

Date

12-12-34 192 C. Mannes Scout