


Section 8 Township 15 Range 18W

Well No. #1 Rohr

Company M. B. Armer

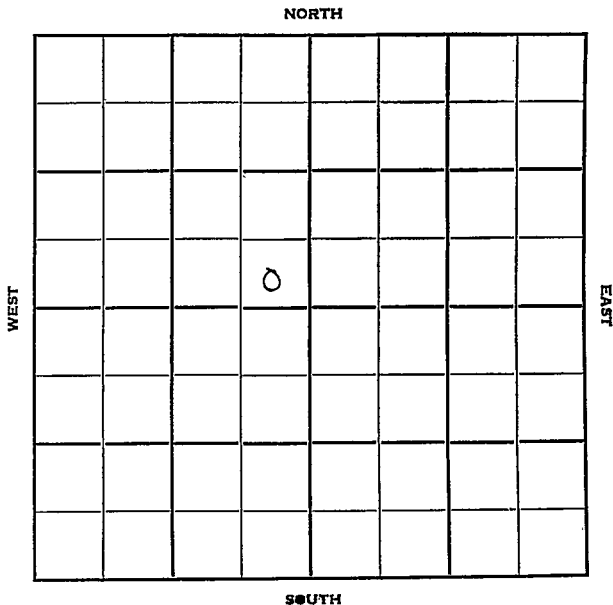

Sec. 8 Twp. 15 R. 18W

Well No. #1 Rohr Farm _____

M. B. Armer Company _____


Ruder Pool Contractor _____

_____ Ft. from N. Line

330' Ft. from S. Line

330' Ft. from E. Line

_____ Ft. from W. Line
SE SE NW

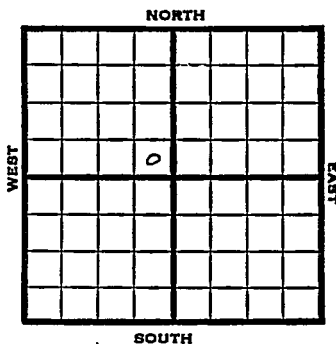

1950 Elev. 2006' REPORT

12/20 Spud 12-16-50
8" @ 162
Anhy 1143-76
Drlg. 2310'

1951
1/3 Spud 12-16-50
D&A TD 3610
8" @ 162 Anhy 1143-76
Heeb. 3235 Lans. 3281
Cong. 3572 Arb. 3599
TD 3610 D&A
ABANDONED

