


Morton
 Map No. KANSAS Sec. 16 Twp. 33 R. 40^w
 Well No. 1- Saw (Low) Farm
Argus Gas Company

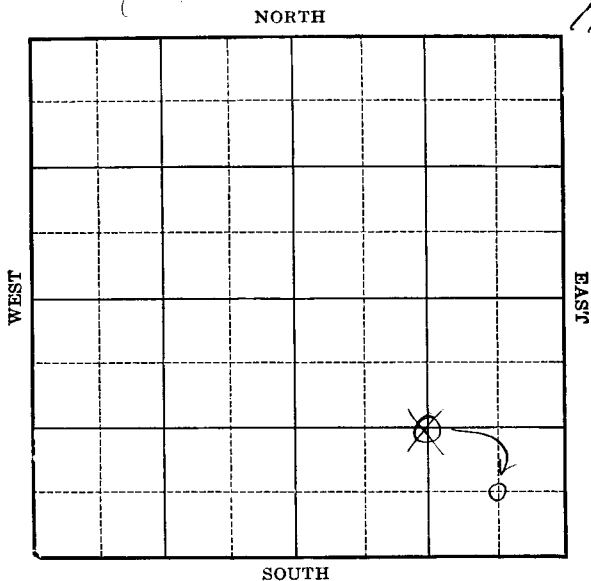

Location _____
 Drilling Remarks _____

Rig Up _____
 Drilling Remarks _____

RECORD

Cased _____ in. _____ ft.
 Sand _____
 Gas _____
 Oil _____
 Total Depth _____

PRODUCTION

1st 24 hrs. Nat. _____
 1st 24 hrs. after shot _____
 Gas _____ cu. ft. _____
 Dry Hole _____
 Abandoned _____

Map No. KANSAS Sec. 16 Twp. 33 R. 40

Well No. 15 Law Farm


Ft. from N. Line

660

Ft. from S. Line

~~7320~~

Ft. from E. Line

660

Ft. from W. Line

~~1.7.2.1~~

WEST

EAST

NORTH

SOUTH

Date _____

REPORT

17/9

Reg

4/16

4/23

4/30

15/7

574

5721

Bad titles
Abandoned


Morton
 Map No. *1055* Sec. *16* Twp. *32* R. *40W*

Well No. *1 Low*

Argus Gas Company

Contractor

SECTION PLAT

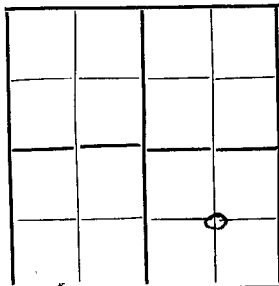

Ft. from N. Line

1320 Ft. from S. Line

1320 Ft. from E. Line

Ft. from W. Line

FIRST REPORTS

Location.....

Rig up.....

Drilling and Remarks:

Rig

RECORD

Cased.....in.,ft.

Sand.....

Gas.....

Oil.....

Total Depth.....

PRODUCTION

1st 24 hrs. Nat.....

1st 24 hrs. after shot.....

Gas.....Cu. Ft.

Dry Hole.....

Abandoned.....

Date

.....192.....Scout

Wilton
 Map No. **KANSAS** Sec. *16* Twp. *23* R. *40W*

Well No. *1 Low*

Argus Gas Company

Contractor

SECTION PLAT

			0

Ft. from N. Line

660 Ft. from S. Line

660 Ft. from E. Line

Ft. from W. Line

SECTION

Location

Rig up

Drilling and Remarks:

*Reported
CSE*

RECORD

Cased _____ in., _____ ft.

Sand _____

Gas _____

Oil _____

Total Depth _____

PRODUCTION

1st 24 hrs. Nat. _____

1st 24 hrs. after shot _____

Gas _____ Cu. Ft.

Dry Hole _____

Abandoned _____

Date

APR 18 1930

192 _____ Scout

Map No. KANSAS Sec. 16 Twp. 33 R. 10W

Well No. 1201

Cergus Gas Company

Contractor

SECTION PLAT

_____ Ft. from N. Line

660 Ft. from S. Line

660 Ft. from E. Line

_____ Ft. from W. Line

ABANDONED

Location _____

Rig up _____

Drilling and Remarks:

Rig
Gas lifted

RECORD

Cased _____ in., _____ ft.

Sand _____

Gas _____

Oil _____

Total Depth _____

PRODUCTION

1st 24 hrs. Nat. _____

1st 24 hrs. after shot _____

Gas _____ Cu. Ft.

Dry Hole _____

Abandoned _____

Date

MAY 21 1930
192 _____ S. J. LEWIS Scout