


Section 6 Township 32 Range 7E

Well No. #2 F.G. Jabara


Company The Texas Co.

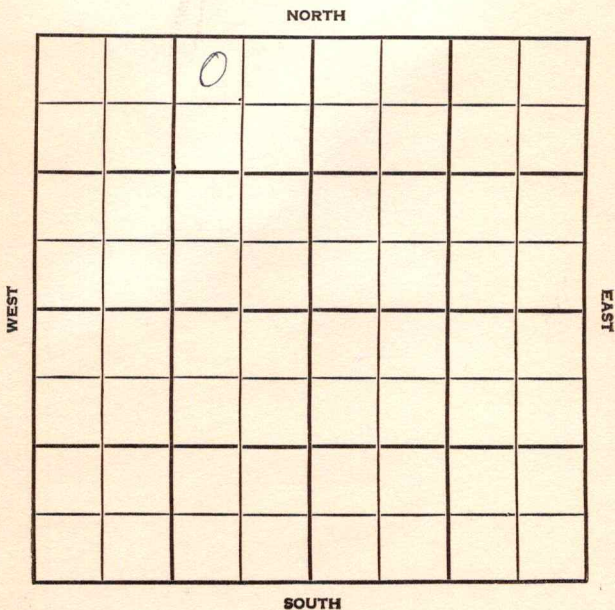

County Cowley Elev. 1384  
 Sec. 6 Twp. 32 Rge. 7E  
 Company The Texas Co.  
 Farm Name F. G. Jabara No. 2

TOPS	DEPTH	LOG	DATUM	Loc. in Sec.
Anh.				NW NE NW
TP.				
H.				
Tr.				
Dg.				
BL.				
L.	<u>1926</u>	<u>1927</u>		Geol.
K.C. <u>Coal</u>	<u>2203</u>	<u>2203</u>		Contr.
B.K.C.				Capitt Drlg
Ce.				
C.				
M.				Pool
M.				Estes
K.				
Mz.				
Ma.				
V.				
S.				
S.				
A.				
R.				
PE.				
G.				
TD.	<u>2260</u>			

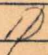

Date Comm. spd. 11-9-56  
10" @ 124, w/125, WOC NOV 21 '56  NOV 28 '56

DEA

County Cowley Elev. \_\_\_\_\_  
 Sec. 6 Twp. 32 Rge. 7E  
 Company The Texas Co.  
 Farm Name F. G. Jabara No. 2

Co.

TOPS	DEPTH	LOG	DATUM	Loc. in Sec.
Anh.				NW NE NW
TP.				
H.				
Tr.				
Dg.				
Bl.				
L.				Geol. _____
K.C.				Contr. _____
B.K.C.				Capitt Drlg.
Ce.				Pool _____
C.				Estes
M.				
M.				
K.				
Mz.				
Me.				
V.				
S.				
S.				
A.				
R.				
PC.				
G.				
TD.				

Use

	6		
	NOV 4 56		
FIRST REPORT			

Date Comm. spd. 11-9-56  
10" @ 124, w/125, WOC

NOV 5 1956

R.G.