


DX 78-1 Cowley

KANSAS

Section 6 Township 32 Range 7E

Well No. #1 M. M. Spangler

Company Texas Company

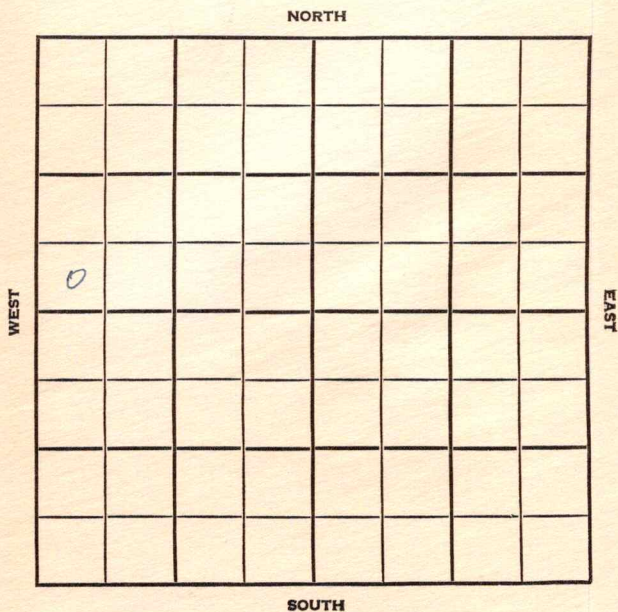

Cowley

KANSAS

SEC.

TWP.

R.

6

32

7E

WELL NO.

#1 M.M. Spangler

FARM

COMPANY

Texas Company

CONTRACTOR

Capitt

Estes

____ FT. FROM N. LINE

____ FT. FROM S. LINE

____ FT. FROM E. LINE

____ FT. FROM W. LINE

SW SW NW

NORTH

WEST

0

EAST

SOUTH

1956

ELEVATION

1361

REPORT

8-15 Location

9-5

Comm 8-9-56

Tops:

KC 2101, Cott Gr 2150,

TD 2289

10" @ 124 w/100

7" @ 2288 RUCT CO 2289

15/2153-58 B/18 GO + 7 GWPH 5 hrs

Tbg to 2145 frac Flw 53 BO +

33 BW 3 hrs 1/2" ch TP 80 flw 75

BO + 62 BW 8 hrs 1/2" ch

Flw 38 BO + 45 BW 7 hrs 1/2" ch

Flw 83 BO + 85 BW 8 hrs 1/2" choke

grav 37 SIP 700 FP 100

COMPLETED

County Cowley **Elev.** _____
Sec. 6 **Twp.** 32 **Rge.** 7E
Company Texas Company
Farm Name M. M. Spangler **No.** 1

TOPS	DEPTH	LOG	DATUM	Loc. in Sec.
Anh.				SW SW NW
Tp.				
H.				
Tr.				
Dg.				
Bl.				
L.				Geol. _____
K.C.				Contr. _____
B.K.C.				Capitt
Ce.				
C.				Pool
M.				Estes
M.				
K.				
Mz.				
Mq.				
V.				
S.				
S.				
A.				
R.				
Pe.				
G.				
T.D.				

FIRST REPORT

AUG 15 '56

Date Comm. _____
Location _____
_____ **T.** _____
_____ **R.** _____
_____ **Sec.** _____
_____ **No.** _____

add S S DUA

310

D.H.

County Cowley Elev. 1361
 Sec. 6 Twp. 32 Rge. 7E
 Company Texas Company
 Farm Name M. M. Spangler No. 1

TOPS	DEPTH	LOG	DATUM	Loc. in Sec.
Anh.				SW SW NW
Tr.				
H.				
Tr.				
Dg.				
BL.				
L.				
K.C. <u>64 R 2101</u>				Geol.
<u>846 COTT. 90. 2150</u>				Contr.
Ce.				Capitt
C.				
M.				Pool
K.				Estes
Mz.				
Mq.				
V.				
S.				
S.				
A.				
R.				
Pe.				
G.				
T.D.	2289			

Date Comm.

Location AUG 22 '56 8-9-56 10" @ 124
1100. 7" @ 2288 RUCT CO
2289 15/2153-58 18 60
+ 7 G.W.P.H. 5 hrs. AUG 29 '56 T69
to 2145 Frac Flw 53 B0 +
33 BW 3 hrs 1/2" ch TP 80
Flw 75 B0 + 62 BW 8 hrs 1/2" ch
Flw 35 B0 + 45 BW 7 hrs 1/2" ch
SEP 5 '56 Flw 83 B0 + 85 BW 8 hrs
1/2 choke 9 hrs 37° SIP 700 FP 100