

Cowley

KANSAS

SECTION 6 TOWNSHIP 32 RANGE 7E

WELL NO. #2 M.M. Spangler

COMPANY The Texas Co.

NORTH

	0						

WEST

EAST

SOUTH

SEC. 6	TWP. 32	R. 7E
-----------	------------	----------

WELL NO. #2 M. M. Spangler FARM

COMPANY The Texas Co.


CONTRACTOR Capitt Drlg  
Estes

\_\_\_\_\_ FT. FROM N. LINE

\_\_\_\_\_ FT. FROM S. LINE

\_\_\_\_\_ FT. FROM E. LINE

\_\_\_\_\_ FT. FROM W. LINE

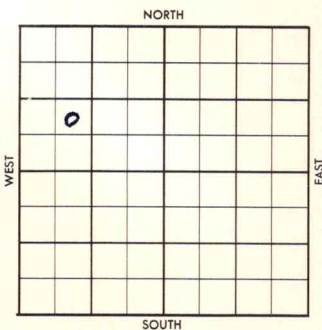

NE SW NW

1956	ELEVATION	REPORT
------	-----------	--------

9-12

Comm 9-8-56  
Drlg 124

County Cowley Elev. \_\_\_\_\_  
 Sec. 6 Twp. 32 Rge. 7E  
 Company The Texas Co.  
 Farm Name M.M. Spangler No. 2

TOPS	DEPTH	LOG	DATUM	Loc. in Sec.
Anh.				NE SW NW
Tp.				
H.				
Tr.				
Dg.				
Bl.				
L.				Geol. _____
K.C.				Contr. _____
B.K.C.				Capitt Drlg
Ce.				Tools
C.				Pool
M.				Estes
M.				
K.				
Mz.				
Me.				
V.				
S.				
S.				
A.				
R.				
PE.				
G.				
T.D.				

SEP 12 1956  
 FIRST REPORT

Date Comm. 9/8/56  
 Drlg. 124

~~130~~

Co.  
Lsc.  
No.  
Sec.  
T.  
R.

County Cowley Elev. 1327  
 Sec. 6 Twp. 32 Rge. 7E  
 Company The Texas Co.  
 Farm Name M.M. Spangler No. 2

TOPS	DEPTH	LOG	DATUM	Loc in Sec.
Anh.				NE SW NW
Tr.				
H.				
Tr.				
Dg.				
Bl.				
L.				Geol.
K.C. <u>Group #</u>		<u>2062</u>		Contr.
<u>B.K. Cat group</u>		<u>2114</u>		Capitt Orlg
<u>Gr. 27d #14</u>		<u>2182</u>		Tools
<u>Gr. KC L1</u>		<u>2248</u>		Pool
M.				Estes
M.				
K.				
Mt.				
Mo.				
V.				
S.				
S.				
A.				
R.				
PE.				COMPLETE
G.				
TD.	<u>2259</u>			

	OCT 3 '56	
COMPLETE		

Date Comm. 9/8/56  
Drlg. 124 SEP 19 '56 10" @ 124 / 125  
Ø 2105 SEP 26 '56 7" @ 2254 / 175  
CO 2224 15/2115 - 20 OCT 3 '56  
Frac Flw 76 B0 + 14 BW 3hr  
1/2" ch TP 180# Flw 108  
B0 + 79 BW 8hr 1/2" ch  
TP 120# Flw 324 B0pd  
+ 237 BWpd.