


Cowley

Section 10 Township 32 Range 7 E

Well No. # 1 Beymer

Company Fred Ayesch

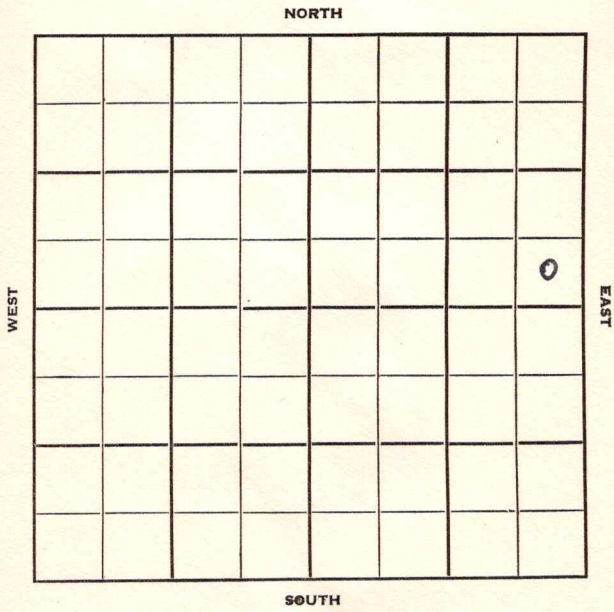

Sec. 10 Twp. 32 R. 7 E

Well No. # 1 Beymer (Beamer) Farm

Fred Ayesch Company

Krisswell Contractor


Ft. from N. Line

330 Ft. from S. Line

330 Ft. from E. Line

Ft. from W. Line

SE SE NE

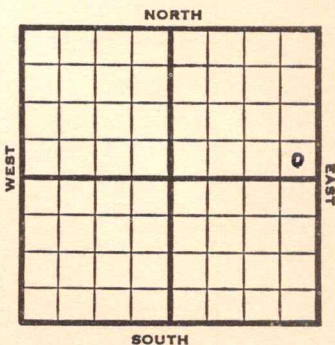

1953

Elev. 1413' REPORT

6/24

Spud 6-19-53
8" @ 80 Layton 2139
Bart 2803'
Dr1g. 2816'

8/19

Spud 6-19-53
Oil Well
TD 3025
8" @ 80
Layton 2139, Bart 2803, Miss 2977
TD 3025,
5" @ 2210
25/2114-22, F/25 bopd 2 mcfg
Comp. 25 bopd 2 mcfgpd

COMPLETED

