


Section 10 Township 32 Range 7 E

Well No. # 3 Beemer (*Beamer*)

Company Fred Ayesch

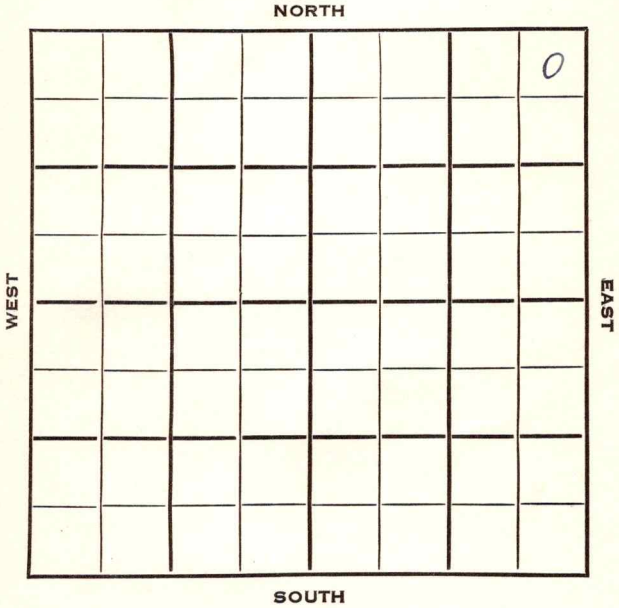

Cowley KANSAS

SEC. 10	TWP. 32	R. 7E ✓
----------------	----------------	----------------

WELL NO. **3 Beemer** FARM

COMPANY **Fred Ayesch**


CONTRACTOR

330 _____ Ft. from N. Line

_____ Ft. from S. Line

330 _____ Ft. from E. Line

_____ Ft. from W. Line

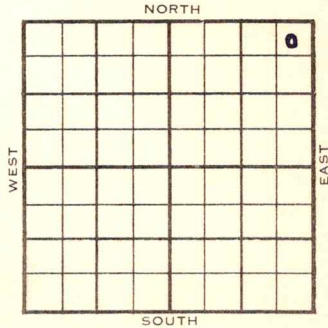

NE NE NE

1954

ELEVATION **1422'**

REPORT

4/21

Location

5/26

Oil well TD 2195 **KC 2069**
Layton 2080 Layton sd. 2124
 DST 2125-35 open 3/4 hr rec 2 1/2 MCFG
 TD 2195 5" @ 2194 60/2137-52
 frac. Comp. 25 BOPD

COMPLETED

County **Cowley** State **Kansas**

Sec. **10** (Blk. **32** (Sur. **7E** Map No. **7E**)
 (Twp.) (Rge.)

Operator **Fred Ayesch**

Well No. **3** Farm **Beemer**

Elev. **1422** Location **NE NE NE**

									0

330 Ft. From **N** Line **NE**

330 Ft. From **E** Line **Quarter**

Ist. Report **APR 21 1954**

Completion _____

Remarks _____

Spudding Date _____

Drlg. Data _____

Location

