


Section 10 Township 32 Range 7 E  
Well No. # 4 Beamer  
Company Fred Ayesh

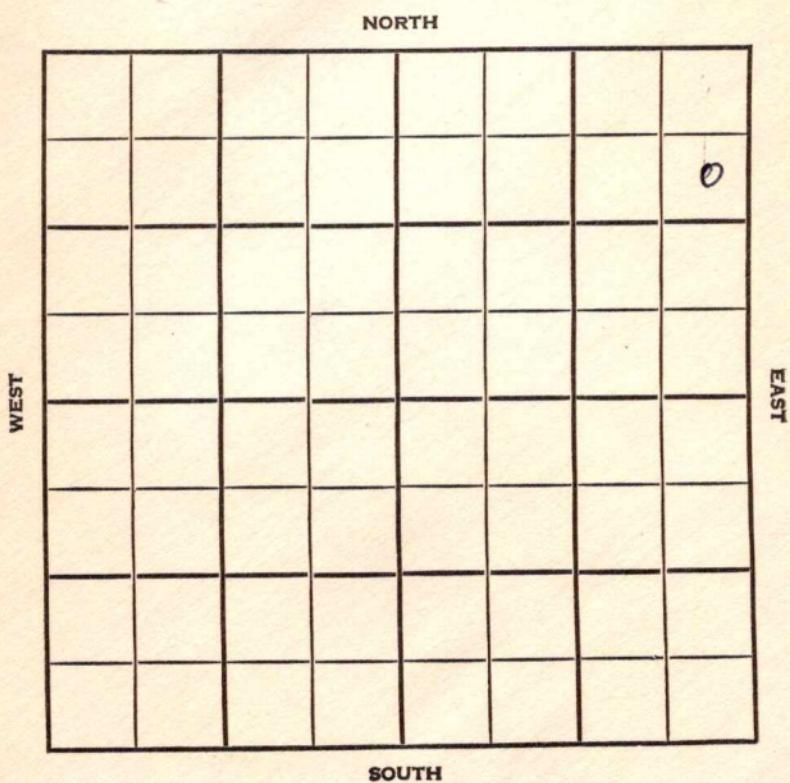

## Cowley KANSAS

SEC.	TWP.	R.
10	32	7 E
WELL NO. # 4 Beamer		
COMPANY FARM		
CONTRACTOR Fred Ayesh		

## N. School Creek Pool


990 Ft. from N. Line

Ft. from S. Line

330 Ft. from E. Line

Ft. from W. Line

SE NE NE

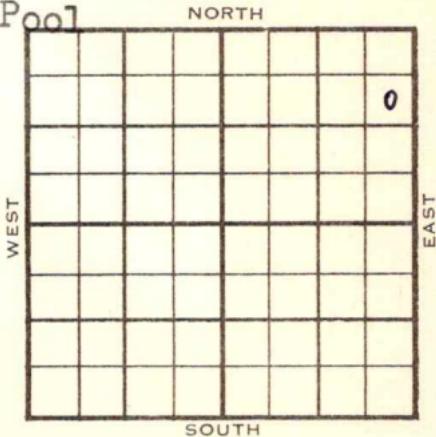

## ELEVATION

1954

## REPORT

1415'

7/21

Spud 7-1-54  
 Oil well TD 2180' 8" @ 62  
 Layton 2129  
 Cored 2122-72, rec 50' TD 2180'  
 4" @ 2179 CO to 2168 84/2129-50  
 frac S & F/13 BOPH  
 Comp. 25 BOPD

## FIRST REPORT

4  
 COMPLETED

County	Cowley		State	Kansas	
Sec.	10	(Blk.) (Twp.)	32	(Sur. Rge.) 7E	Map No.
Operator	Fred Ayesch				
Well No.	4	Farm	Beamer		
Elev.	1415	Location	SE NE NE		
			990	Ft. From	N Line
			330	Ft. From	E Line
			1st. Report	JUL 21 1954	
			Completion	JUL 21 1954	
			Remarks	N. School Creek Pool	
			Spudding Date	7-1-54	

Drig. Data      Oil well      TD 2180  
 8" @ 62      Layton 2129      Core 2122-72  
 rec. 50"      TD 2180      4" @ 2179 C° to 2168  
 84/ 2129-50      frac      S & F/ 13 boph  
 Comp. 25 bopd

J. G. McGEHEE