

DX 78-1


Cowley

KANSAS

Section 10 Township 32 Range 7E

Well No. #10 Beamer

Company BMD Mang't.

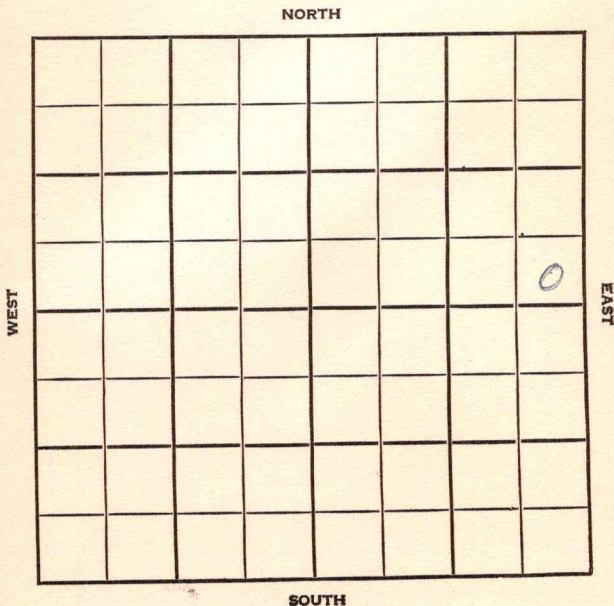

County Cowley Elev. _____
 Sec. 10 Twp. 32 Rgs. 7E
 Company BMD Mang't
 Farm Name Beamer No. 10

TOPS	DEPTH	LOG	DATUM	Loc. in Sec.
Anh.				SE SE NE
Tp.				Twin to #1
H.				
Tr.				
Dg.				
Bl.				
L.				Geol. _____
K.C.				Contr. _____
B.K.C.				Crisswell Tools
Ce.				
C.				Pool
M.				
M.				
K.				
Mz.				
Ma.				
V.				
S.				
S.				
A.				
R.				
PE.				
G.				
T.D.				

	DEC	5	55
			0
FIRST REPORT			

Date Comm. 11-29-56
8 5/8" 150, Lay sd 2112, RTD 2192, 5 1/2 @ 2190

~~30~~

Co.
No.
Sec.
T.
R.

County Cowley Elev. _____
 Sec. 10 Twp. 32 Rge. 7E
 Company BMD Mang't
 Farm Name Beamer No. 10

TOPS	DEPTH	LOG	DATUM
Anh.			
TP.			
H.			
Tr.			
Dg.			
BL.			
L. <u>ayton</u>	<u>2112</u>		
K.C.			
B.K.C.			
Ce.			
C.			
M.			
M.			
K.			
Mz.			
Mo.			
V.			
S.			
S.			
A.			
R.			
PE.			
G.			
TD.	<u>2192</u>		

Loc. in Sec. SE SE NE
Twin to #1
 Geol. _____
 Contr. _____
Crisswell Tools
 Pool _____

DEC 20 '56
 COMPLETE

Date Comm. 11-29-56
8 5/8" 150, Lay sd 2112, RTD 2192, 5 1/2 @ 2190

DEC 12 '56 / DEC 19 '56 32/2116-24

28/2139-46 Frac Pop
est. P 25 Bopd + wtr

Co.

Log

No.

Sec.

T.

R.