


Section 8 Township 15 Range 18-W

Well Number 2- C.Ruder

Company Palmer et al

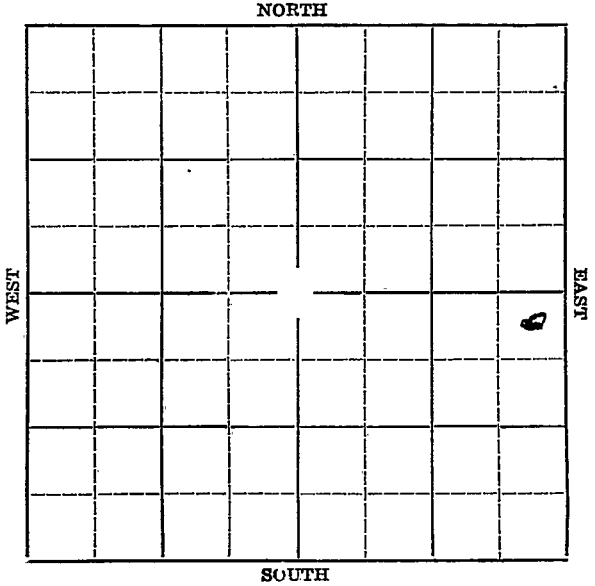

Map No. KANSAS Sec. 8 Twp. 15 R. 18W

Well No. #2 C Ruder Farm


Palmer et al Company

330' Ft. from N. Line

\_\_\_\_\_ Ft. from S. Line

330' Ft. from E. Line

\_\_\_\_\_ Ft. from W. Line

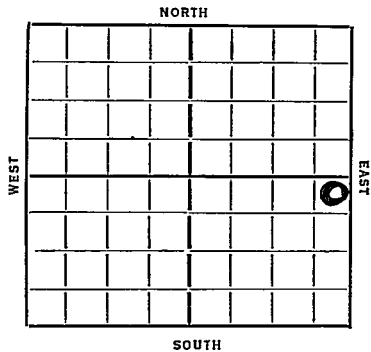

Elev. 1993

Date	REPORT
1936	
6/10	Rig.
6/18	Sil. 3565'-7" @ 3567'. T.D. 3569'. Rigging up standard tools.
6/25	Oswald 3260'. Drlg. 3300'.
7/2	Sil. 3554-55'. T.D. R.U.S.T.
7/9	--
7/16	Cored 3556' to 62'. Saturation.
7/23	--7/30--
8/6	Total Depth 3594'. 1800' of oil in 8 hours.
8/13	--
8/20	Waiting on standard tools.
8/27	9/3-- 9/10-- 9/18-- 9/24-- 10/1--
10/8	10/15--10/22--
10/29	Shut down.
11/4	Sil. 3554
	T. D. 3594
	Water D & A
	ABANDONED

Map No. 74 Sec. 5 Twp. 15 R. 18W

Well No. 2 O Rucker

Palmer & Co. Company

Contractor

SECTION PLAT

320 Ft. from N. Line

\_\_\_\_\_ Ft. from S. Line

330 Ft. from E. Line

\_\_\_\_\_ Ft. from W. Line

			o

FIRST REPORT

Location \_\_\_\_\_

Rig up \_\_\_\_\_

Drilling and Remarks:

*Rig*

RECORD

Cased \_\_\_\_\_ in., \_\_\_\_\_ ft.

Sand \_\_\_\_\_

Gas \_\_\_\_\_

Oil \_\_\_\_\_

Total Depth \_\_\_\_\_

PRODUCTION

1st 24 hrs. Nat. \_\_\_\_\_

1st 24 hrs. after shot \_\_\_\_\_

Gas \_\_\_\_\_ Cu. Ft.

Dry Hole \_\_\_\_\_

Abandoned \_\_\_\_\_

Date

JUN 20 1936

19

S. J. LEWIS

Scout

Map No. 74 Sec. 8 Twp. 15 R. 18W

Well No. 2 @ Ruder.

Palmer & Co. Company

Contractor

**SECTION PLAT**

			0

320 Ft. from N. Line

\_\_\_\_\_ Ft. from S. Line

330 Ft. from E. Line

\_\_\_\_\_ Ft. from W. Line

**ABANDONED**

Location \_\_\_\_\_

Rig up \_\_\_\_\_

Drilling and Remarks:

Sil 3554

Water.

J. J. A.

**RECORD**

Cased \_\_\_\_\_ in., \_\_\_\_\_ ft.

Sand \_\_\_\_\_

Gas \_\_\_\_\_

Oil \_\_\_\_\_

Total Depth 3594

**PRODUCTION**

1st 24 hrs. Nat. \_\_\_\_\_

1st 24 hrs. after shot \_\_\_\_\_

Gas \_\_\_\_\_ Cu. Ft.

Dry Hole \_\_\_\_\_

Abandoned \_\_\_\_\_

Date

NOV 4 1936

S. J. LEWIS Scout