


Well No. 1 Harris Farm

Simmons et al Company

**NORTH**

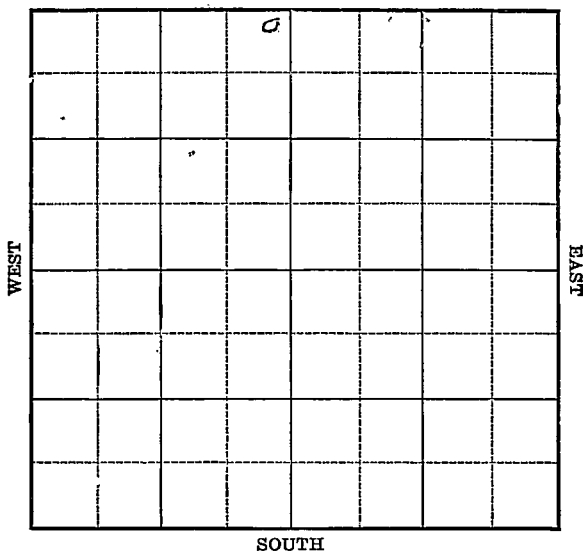

3

Location \_\_\_\_\_

### Drilling Remarks

## Rig Up

### Drilling Remarks

# RECORD

Cased\_\_\_\_\_in. \_\_\_\_\_ft.

# Sand

Gas \_\_\_\_\_

# Oil

Total Depth\_\_\_\_\_

## PRODUCTION

1st 24 hrs. Nat. \_\_\_\_\_

1st. 24 hrs. after shot\_\_\_\_\_

Gas\_\_\_\_\_cu. ft.

## Dry Hole\_\_\_\_\_

Abandoned \_\_\_\_\_

Map No. Kan Sec. 19 Twp. 22 R. 11


Well No. 1 Harris Farm  
Simmons Company

250 Ft. from N. Line

\_\_\_\_\_ Ft. from S. Line

250 Ft. from E. Line

\_\_\_\_\_ Ft. from W. Line

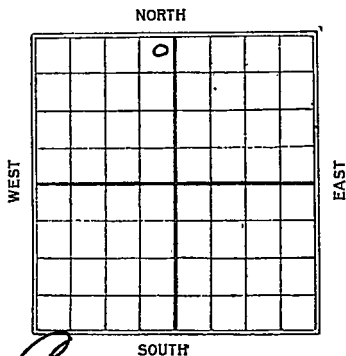

① FFSE

②

| Date        | REPORT                      |
|-------------|-----------------------------|
| <u>1925</u> |                             |
| <u>7/17</u> | <u>Sp. 2071 - 2102 T.D.</u> |
|             | <u>140/90 hls</u>           |
|             |                             |
|             |                             |
Map No. 21 5406 Sec. 19 Twp. 22 R. 11Well No. 1 HarrisSimmons Jal Company

## FIRST REPORTS

Contractor

## SECTION PLAT

## COMPLETION

250 Ft. from N. Line

Ft. from S. Line

250 Ft. from E. Line

Ft. from W. Line

"OFFSE"

|  |   |  |  |
|--|---|--|--|
|  | 0 |  |  |
|  |   |  |  |
|  |   |  |  |
|  |   |  |  |

Location

Rig up

Drilling and Remarks:

old well deeper140790 bls.

## RECORD

Cased \_\_\_\_\_ in., \_\_\_\_\_ ft.

Sand 2071-2102

Gas \_\_\_\_\_

Oil \_\_\_\_\_

Total Depth 2102

## PRODUCTION

1st 24 hrs. Nat. \_\_\_\_\_

1st 24 hrs. after shot \_\_\_\_\_

Gas \_\_\_\_\_ Cu. Ft.

Dry Hole \_\_\_\_\_

Abandoned \_\_\_\_\_

Date

JUL 17 1925

CHAS. L. SHERWOOD

192

Scout

Sherwood Co

Map No. **KANSAS** Sec. **19** Twp. **22** R. **11**Well No. **1** **Harris****Simmons** **Jal** Company

Contractor

COMPLETED **Note**

## SECTION PLAT

**250** Ft. from N. Line

Ft. from S. Line

**250** Ft. from E. Line

Ft. from W. Line

|  |  |  |  |
|--|--|--|--|
|  |  |  |  |
|  |  |  |  |
|  |  |  |  |
|  |  |  |  |

, OFFSET

**3rd completion.****Abandoned & acct collapsed casing.**

ABANDONED

## RECORD

~~Location~~

Rig up

Drilling and Remarks:

Cased in., ft.

Sand **2071-2102'**

Gas

Oil

Total Depth **2102'**

## PRODUCTION

1st 24 hrs. Nat. \_\_\_\_\_

1st 24 hrs. after shot \_\_\_\_\_

Gas \_\_\_\_\_ Cu. Ft.

Dry Hole \_\_\_\_\_

Abandoned ☒

Date

**AUG 20 1925****CHAS. L. SHERWOOD****192**

Scout