


Section 8 Township 15 Range 18-W

Well No. #1 Ruder ^{2 (KGS DRL 10-24-25)}

Company Jones, Shelborne & Farmer

NORTH

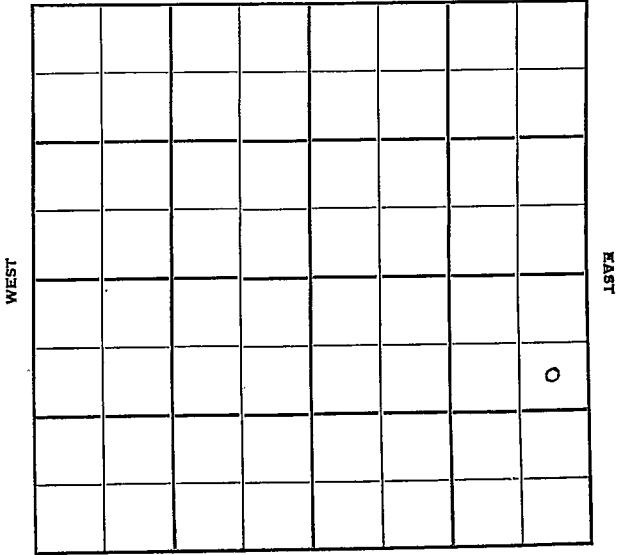

SOUTH

WEST

EAST

Ellis

15

18W

Sec. 8 Twp. _____ R. _____

Well No. #1 Ruder Farm _____

Jones, Shelborne & Farmer Company _____

Madden Pool Contractor _____


990' Ft. from N. Line

_____ Ft. from S. Line

330' Ft. from E. Line

_____ Ft. from W. Line

SE NE SE

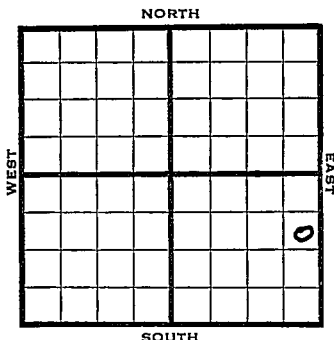

1950 Elev 1992 REPORT

8/23 Spud 8-19-50
8-5/8" @ 146'
Drlg. 605'

9/6 8 5/8" @ 146
Anhy 1159
Cong 3557
TD 3605
D&A

Lans 3269
Arb 3588

ABANDONED

