


KANSAS

Map No. Kans Sec. 18 Twp. 22 R. 11Well No. 4 Copton FarmJ. R. Simmons Company

NORTH

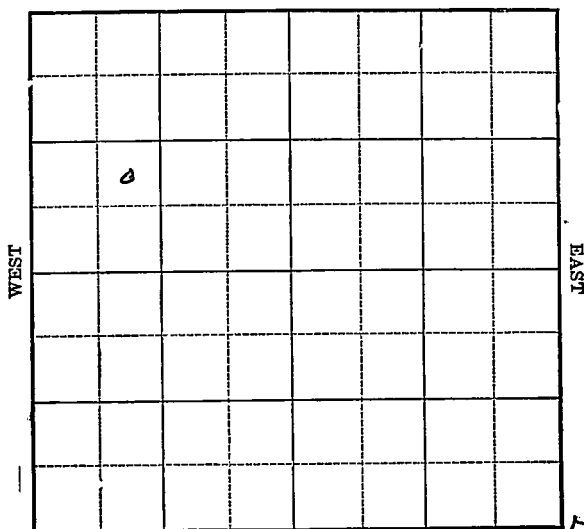

SOUTH

Location _____

Drilling Remarks _____

Rig Up _____

Drilling Remarks _____

RECORD

Cased _____ in. _____ ft.

Sand _____

Gas _____

Oil _____

Total Depth _____

PRODUCTION

1st 24 hrs. Nat. _____

1st 24 hrs. after shot _____


Gas _____ cu. ft.

Dry Hole _____

Abandoned _____

KANSAS *Greenwood*
 Map *18* Sec. *18* Twp. *22* R. *11*
 Well No. *4* *Clopton* Farm
J. R. Simmons Company

NORTH

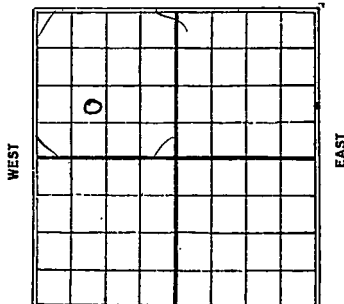

Ft. from N. Line

990 Ft. from S. Line

Ft. from E. Line

990 Ft. from W. Line

SOUTH

1926

Date

REPORT

<i>10/6</i>	<i>Bldg rig</i>
<i>10/18</i>	<i>Rigging up</i>
<i>10/27</i>	<i>Rig</i>
<i>11/11</i>	<i>same</i>
<i>11/17</i>	<i>Rigging up</i>
<i>11/23</i>	<i>same</i>
<i>12/8</i>	<i>Rigged up & S.D.</i>
<i>12/15</i>	<i>same</i>
<i>12/22</i>	—
<i>12/30</i>	—
<i>1927</i>	
<i>1/6</i>	—
<i>1/13</i>	—
<i>1/19</i>	—
<i>1/26</i>	—
<i>2/3</i>	—
<i>2/10</i>	—
<i>2/17</i>	—
<i>2/24</i>	—
<i>3/2</i>	—
<i>3/9</i>	—
<i>3/16</i>	—

3/24 - Rigged up + S.D.

3/30

12/14

4/7

12/21

4/13

12/29

4/20

~~12/28~~

4/27

1/5 - Rigged up - S.D.

5/5

1/11

5/12

1/18

5/18

1/26

5/25

2/2

6/1

2/9

6/7

2/16

6/15

2/23

6/22

3/1

6/29

3/8

7/7

3/16

7/13

3/22

7/20

3/29

7/28

4/5

8/4

4/12

8/10

4/19

8/18

4/26

8/24

5/3

9/1

5/10

9/7

5/18

9/14

5/24

9/29

5/31

10/6

6/7

10/12

6/14

10/19

6/21

10/27

6/28

11/2

7/6

11/9

7/13

11/16

7/19

11/23

7/26

11/30

8/2

12/7

8/9

8/16


Map No. KANSAS Sec. 18 Twp. 22 R. 11
 Well No. 4 - Copton Farm
L. H. Simmons Company

_____ Ft. from N. Line

990 Ft. from S. Line

_____ Ft. from E. Line

990 Ft. from W. Line

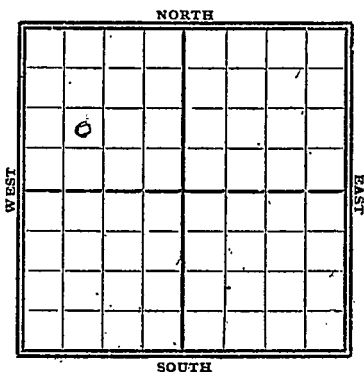

1928

Date

REPORT

8/23 Rig up + G.D.

8/28

9/4

9/12

9/19

9/26

10/3

Abd. Rig


21 **KANSAS** Sec. 18 Twp. 22 R. 11

Well No. 4 **Chopton**

T. B. Simmons Company

Contractor

SECTION PLAT

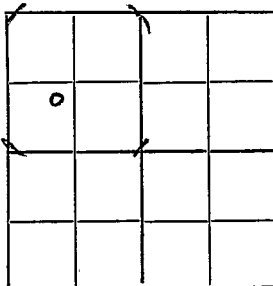

_____ Ft. from N. Line

990 _____ Ft. from S. Line

_____ Ft. from E. Line

990 _____ Ft. from W. Line

FIRST REPORTS

Location _____

Rig up _____

Drilling and Remarks:

Big Rig

RECORD

Cased _____ in., _____ ft.

Sand _____

Gas _____

Oil _____

Total Depth _____

PRODUCTION

1st 24 hrs. Nat. _____

1st 24 hrs. after shot _____

Gas _____ Cu. Ft.

Dry Hole _____

Abandoned _____

Date

OCT 6 1926

CHAS. L. SHERWOOD

Scout

K21 KANSAS

MAP NO.

SEC.

18

TWP.

22

R.

11

WELL NO.

4

Clapton

T.B. Simmons

COMPANY

CONTRACTOR

SECTION PLAT

COMPLETED

Ft. FROM N. LINE

990

Ft. FROM S. LINE

Ft. FROM E. LINE

990

Ft. FROM W. LINE

ABANDONED

0			

LOCATION

RIG UP

DRILLING AND REMARKS:

Rig

abd

RECORD

CASED IN. FT.

SAND

GAS

OIL

TOTAL DEPTH

PRODUCTION

1ST 24 HRS. NAT.

1ST 24 HRS. AFTER SHOT

GAS

CU. FT.

DRY HOLE

ABANDONED

DATE

OCT 3 1928

CHAS. L. SHERWOOD

192

SCOUT