

KANSAS

Butler


Section 36 Township 25 Range 4E

Well No. 20 Adsit

Company Cities Service

Misc.

NORTH

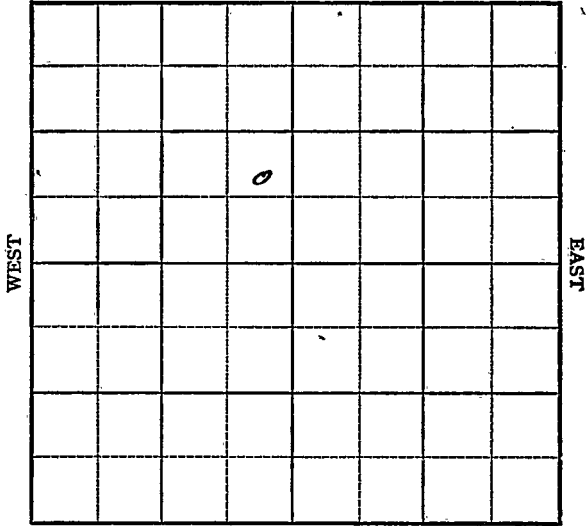

SOUTH

KANSAS

Butler

Sec. 36 Twp. 25 R. 4E ✓

Well No. #20 Adsit Farm

Cities Service Company


Miscellaneous

_____ Ft. from N. Line

990' Ft. from S. Line

330' Ft. from E. Line

_____ Ft. from W. Line

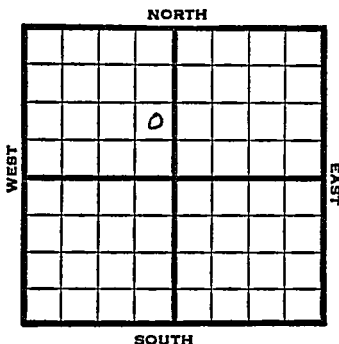

NE SE NW

1949 . Elev. 1396' REPORT

- 2/16 8" @ 78'
- 2/23 "
- 3/2 "
- 3/8 "
- 3/16 Lansing 1717'
Arbuckle 2429'
TD 2433'
5" @ 2430'
- 3/23 TD 2459
50 qts
2436-58-1400' oil
- 3/30 Arb 2429'
5" @ 2430'
40' qts
Pump 99 Oil Pot.
Gr. 380
TD 2459'
COMPLETED

Map No. _____ Sec. 36 Twp. 25 R. 4E

Well No. 20 Adsit

Cities Service Company

FIRST REPORT Contractor

NE SE NW

SECTION PLAT

_____ Ft. from N. Line

990 Ft. from S. Line

330 Ft. from E. Line

_____ Ft. from W. Line

	o		

Butler County

Location _____

Rig up _____

Drilling and Remarks:

8" @ 78

RECORD

Cased _____ in., _____ ft.

Sand _____

Gas _____

Oil _____

Total Depth _____

PRODUCTION

1st 24 hrs. Nat. _____

1st 24 hrs. after shot _____

Gas _____ Cu. Ft.

Dry Hole _____

Abandoned _____

Date

FEB 16 1949 19

S. J. LEWIS Scout

Kansas

Map No. 14 Sec. 36 Twp. 25 R. 4EWell No. 20 Adsit

Cities Service Company

COMPLETE

Contractor

NE SE NW

E 11396
SECTION PLAT Ft. from N. Line990 Ft. from S. Line330 Ft. from E. Line Ft. from W. Line

Butler County

	o		

Location

Rig up

Drilling and Remarks:

Art 24295" C2430409 ftPump 99 oil out350 ft

RECORD

Cased in., ft.Sand Gas Oil Total Depth 2459

PRODUCTION

1st 24 hrs. Nat. 1st 24 hrs. after shot Gas Cu. Ft.Dry Hole Abandoned

Date

MAR 30 194919S. J. LEWISScout