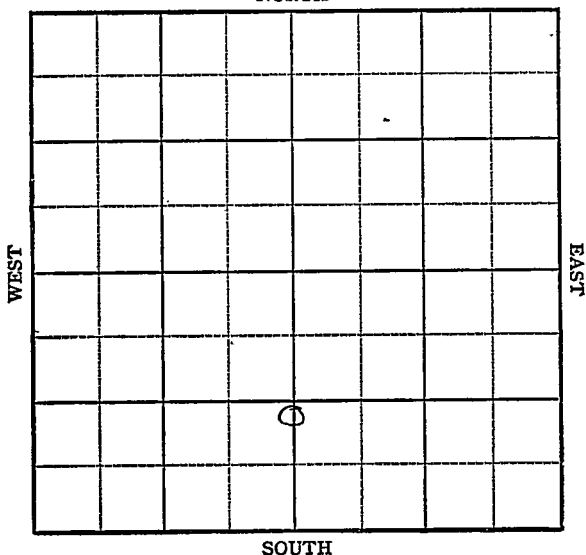


KANSAS Butler

Section 36 Township 25 Range 4EWell No. 3 DickmanCompany E. DustinMisc.
NORTH

KANSAS Butler ✓

Sec. 36 Twp. 25 R. 4E

Well No. 3 Dickman Farm

E. Dustin Company

Miscellaneous


 Ft. from N. Line

1110 Ft. from S. Line

2640 Ft. from E. Line

 Ft. from W. Line

C N L S $\frac{1}{2}$ S $\frac{1}{2}$ Sec.

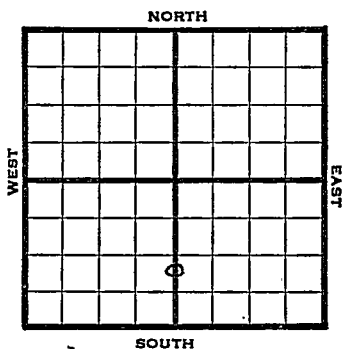

1948 Elev. 1397' REPORT

8/25 Machine
9/1 Drlg. 745'

9/8 10" @ 1565'
Drlg. 1710'

9/14 8" @ 2065'
Drlg. 2430'

9/22 Miss 2504'
TD 2525'

ABANDONED

Butler County Kansas StateMap No. _____ Sec. 36 Twp. 25 R. 4EWell No. 3 DickmanE. Dustin Company

FIRST REPORT

Contractor

C N L $S\frac{1}{2}$ $S\frac{1}{2}$ Sec.

SECTION PLAT

_____ Ft. from N. Line

1110 Ft. from S. Line2640 Ft. from E. Line

_____ Ft. from W. Line


Miscellaneous

Remarks:

MachineDate AUG 25 1948Scout S. J. LEWIS

Butler County Kansas StateMap No. 14 Sec. 36 Twp. 25 R. 4EWell No. 3 DickmanE. Dustin Company**ABANDONED**

Contractor

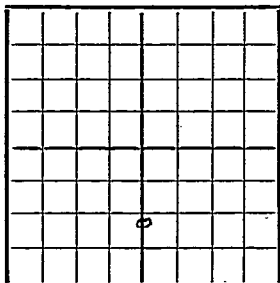C N L $S\frac{1}{2}$ $S\frac{1}{2}$ Sec.E 11/18/97
SECTION PLAT Ft. from N. Line1110 Ft. from S. Line2640 Ft. from E. Line Ft. from W. LineMiscellaneous

Remarks:

*Misc 2504**TD 2525*

Date

SEP 22 1948

Scout

S. J. LEWIS