

Butler

FORM 51

KANSAS
LE

Section 35 Township 25 Range 4E

Well No. #4 Rice-Tanner

Company Wilson Oil

NORTH

WEST

EAST

SOUTH

0

Butler KANSAS

SEC.	TWP.	R.
35	25	4E

WELL NO.

4 Rice-Tanner

FARM

COMPANY

Wilson Oil

CONTRACTOR

Wixson

El Dorado Pool


990 Ft. from N. Line

Ft. from S. Line

990 Ft. from E. Line

Ft. from W. Line

SW NE SE

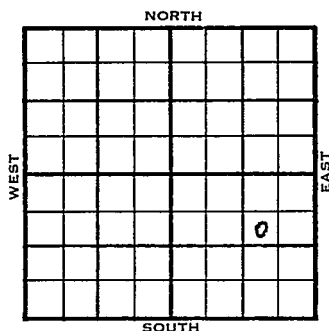

1953

ELEVATION

1381'

REPORT

12/9


Spud 11-30-53
 $15\frac{1}{2}''$ @ 92'
 Drlg. 875'

1954
1/6

Spud 11-30-53
 Oil Well
 TD 2392'
 $15\frac{1}{2}''$ @ 92'
 10" @ 1690'
 KC. 1955', B KC 2105', Arb. 2365'
 5" @ 2373'
 TD 2392'
 FU 70' oil 20 hrs.
 Comp. 15 bopd

COMPLETED

J. G. McGEHEE

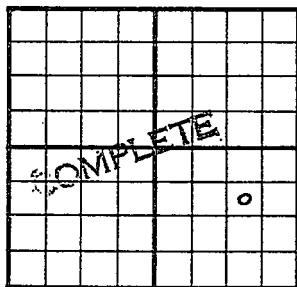County Butler State KansasSec. 35 (Blk. Twp.) 25 (Sur. Rge.) 4E Map No.Operator Wilson OilWell No. 4 Farm Rice-TannerElev. 1381 Location SW NE SE990 Ft. From N Line SE990 Ft. From E Line Quarter

1st. Report

Completion JAN 6 1954Remarks ElDorado PoolWixson - Contr.Spudding Date 11-30-53Drlg. Data Oil well TD 239215 $\frac{1}{2}$ " @ 92 10" @ 1690 KC 1955B KC 2105 Arb. 2365 5" @ 2373TD 2392 FU 70' oil 20 hr.Comp. 15 bopd

J. G. McGEHEE