

KANSAS ButlerSection 36 Township 25 Range 4EWell No. 21 Adist "B" (*Adist*)Company Cities Service

Misc.

NORTH

		6					

WEST

EAST

SOUTH

KANSAS

Butler

Sect. 36 Twp. 25 R. 4E ✓

Well No. #21 Adist "B" Farm _____

Cities Service

Company


Miscellaneous

_____ Ft. from N. Line

990' Ft. from S. Line

990' Ft. from E. Line

_____ Ft. from W. Line

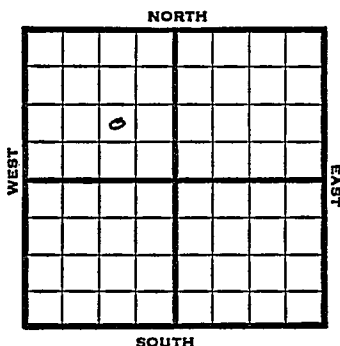

NW SE NW

1949

Elev 1391' REPORT

4/6

t
8" @ 96'
Drlg. 365'

4/12

Simpson 2420'
TD 2423'
5" @ 2420'

4/20

"

4/27

"

5/4

TD 2449'
Arb. 2425'
5" @ 2420'
40 qts 2424-49
Pump 140 Oil Pot
38° Gr.
Comp

COMPLETED

Kansas

Map No. _____ Sec. 36 Twp. 25 R. 4EWell No. 21 Adist "B"

Cities Service

Company

FIRST REPORT

Contractor

NW SE NW

SECTION PLAT

	Δ		

_____ Ft. from N. Line

990 Ft. from S. Line990 Ft. from E. Line

_____ Ft. from W. Line

Butler County

Location _____

Rig up _____

Drilling and Remarks:

8" @ 96

drlg. 365

RECORD

Cased _____ in., _____ ft.

Sand _____

Gas _____

Oil _____

Total Depth _____

PRODUCTION

1st 24 hrs. Nat. _____

1st 24 hrs. after shot _____

Gas _____ Cu. Ft.

Dry Hole _____

Abandoned _____

Date

APR 6 1949 19

S. J. LEWIS

Scout

Map No. K14 Sec. 36 Twp. 25 R. 4E

Well No. 21 Adist "B"

Cities Service Company

COMPLETE

Contractor

NW SE NW

E. 1391
SECTION PLAT

	6		

Ft. from N. Line

990 Ft. from S. Line

990 Ft. from E. Line

Ft. from W. Line

Butler County

Location

Rig up

Drilling and Remarks:

Run 2425-

5" @ 2420

409 to 2424-49

Pump 140 oil Rod

38-2-4

RECORD

Cased _____ in., _____ ft.

Sand _____

Gas _____

Oil _____

Total Depth 2429

PRODUCTION

1st 24 hrs. Nat. _____

1st 24 hrs. after shot _____

Gas _____ Cu. Ft.

Dry Hole _____

Abandoned _____

Date

MAY 4 1949

19

S. J. LEWIS

Scout