

Section 36 Township 25 Range 4E

Well No. 22 Adsit

Company Cities Service

Misc.
NORTH

WEST

EAST

SOUTH

Butler

KANSAS



Sec. 36 Twp. 25 R. 4E

Well No. #22 Adsit Farm

Cities Service Company

Miscellaneous

 Ft. from N. Line

660'


 Ft. from S. Line

 Ft. from E. Line

990'

 Ft. from W. Line

C E L SW NW

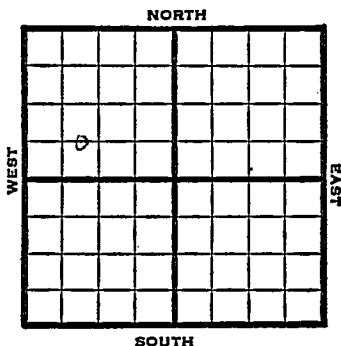

1949 Elev. 1386' REPORT

8/10

8" @ 69'

8/16

Arbuckle 2425'

TD 2426'

5" @ 2425'

8/24

Drlg. 2451'

8/31

TD 2455'

40 qts to 2434-50

9/7

Arb 2425'

5" @ 2425'

40 qts

Pump 30 oil & 65 W Pot.

Grav. 38°

TD 2455'

COMPLETED

Kansas

Map No. _____ Sec. 36 Twp. 25 R. 4E

Well No. 22 Adsit

Cities Service

Company

C E L SW NW

Contractor

FIRST REPORT
SECTION PLAT

_____ Ft. from N. Line

660 _____ Ft. from S. Line

_____ Ft. from E. Line

990 _____ Ft. from W. Line

a			

Butler County

RECORD

Location _____

Cased _____ in., _____ ft.

Rig up _____

Sand _____

Drilling and Remarks:

Gas _____

Oil _____

8" @ 69

Total Depth _____

PRODUCTION

1st 24 hrs. Nat. _____

1st 24 hrs. after shot _____

Gas _____ Cu. Ft.

Dry Hole _____

Abandoned _____

Date

AUG 10 1949 19

S. J. LEWIS

Scout

Map No. K14 Sec. 36 Twp. 25 R. 4E

Well No. 22 Adsit

Cities Service Company

COMPLETE

Contractor

C E L SW NW

E11386
SECTION PLAT

 Ft. from N. Line

660 Ft. from S. Line

 Ft. from E. Line

990 Ft. from W. Line

0			

Butler County

Location

Rig up

Drilling and Remarks:

Cor 2425

5" @ 2425

409 ft.

Prod 30 oil 460 ft.

BT

38° E

RECORD

Cased in., ft.

Sand

Gas

Oil

Total Depth 2425

PRODUCTION

1st 24 hrs. Nat.

1st 24 hrs. after shot

Gas Cu. Ft.

Dry Hole

Abandoned

Date

SEP 7 1949 19

S. J. LEWIS

Scout